
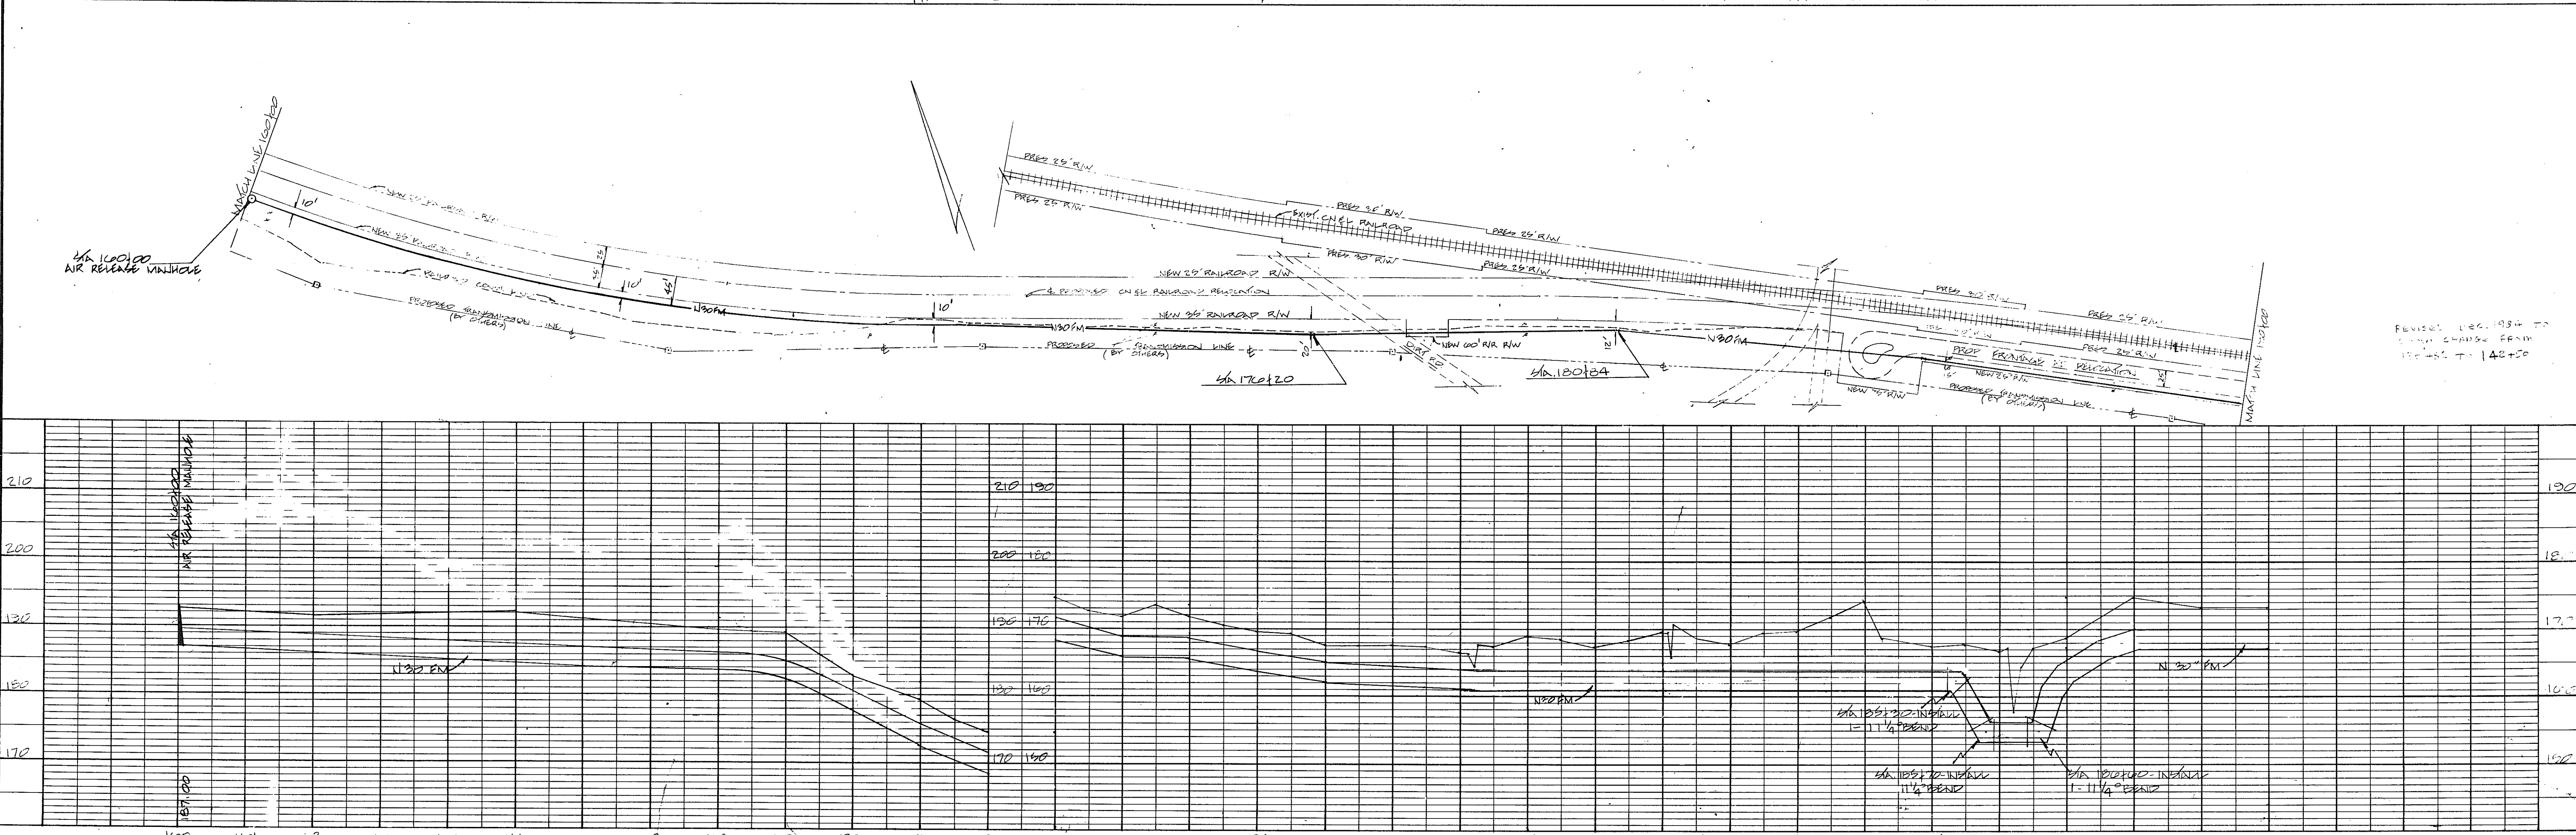


CITY OF COLUMBIA, S.C.
DEPARTMENT OF UTILITIES & ENGINEERING

THIS MAP OR PLAN IS THE PRODUCT OF COMPILATION, OR WAS PRODUCED BY OTHERS. IT IS PROVIDED FOR INFORMATION ONLY AND THE CITY OF COLUMBIA MAKES NO REPRESENTATIONS AS TO ITS ACCURACY. ITS USE WITHOUT FIELD VERIFICATION IS AT THE SOLE RISK OF THE USER.

RECEIVED
JUN 14 1977

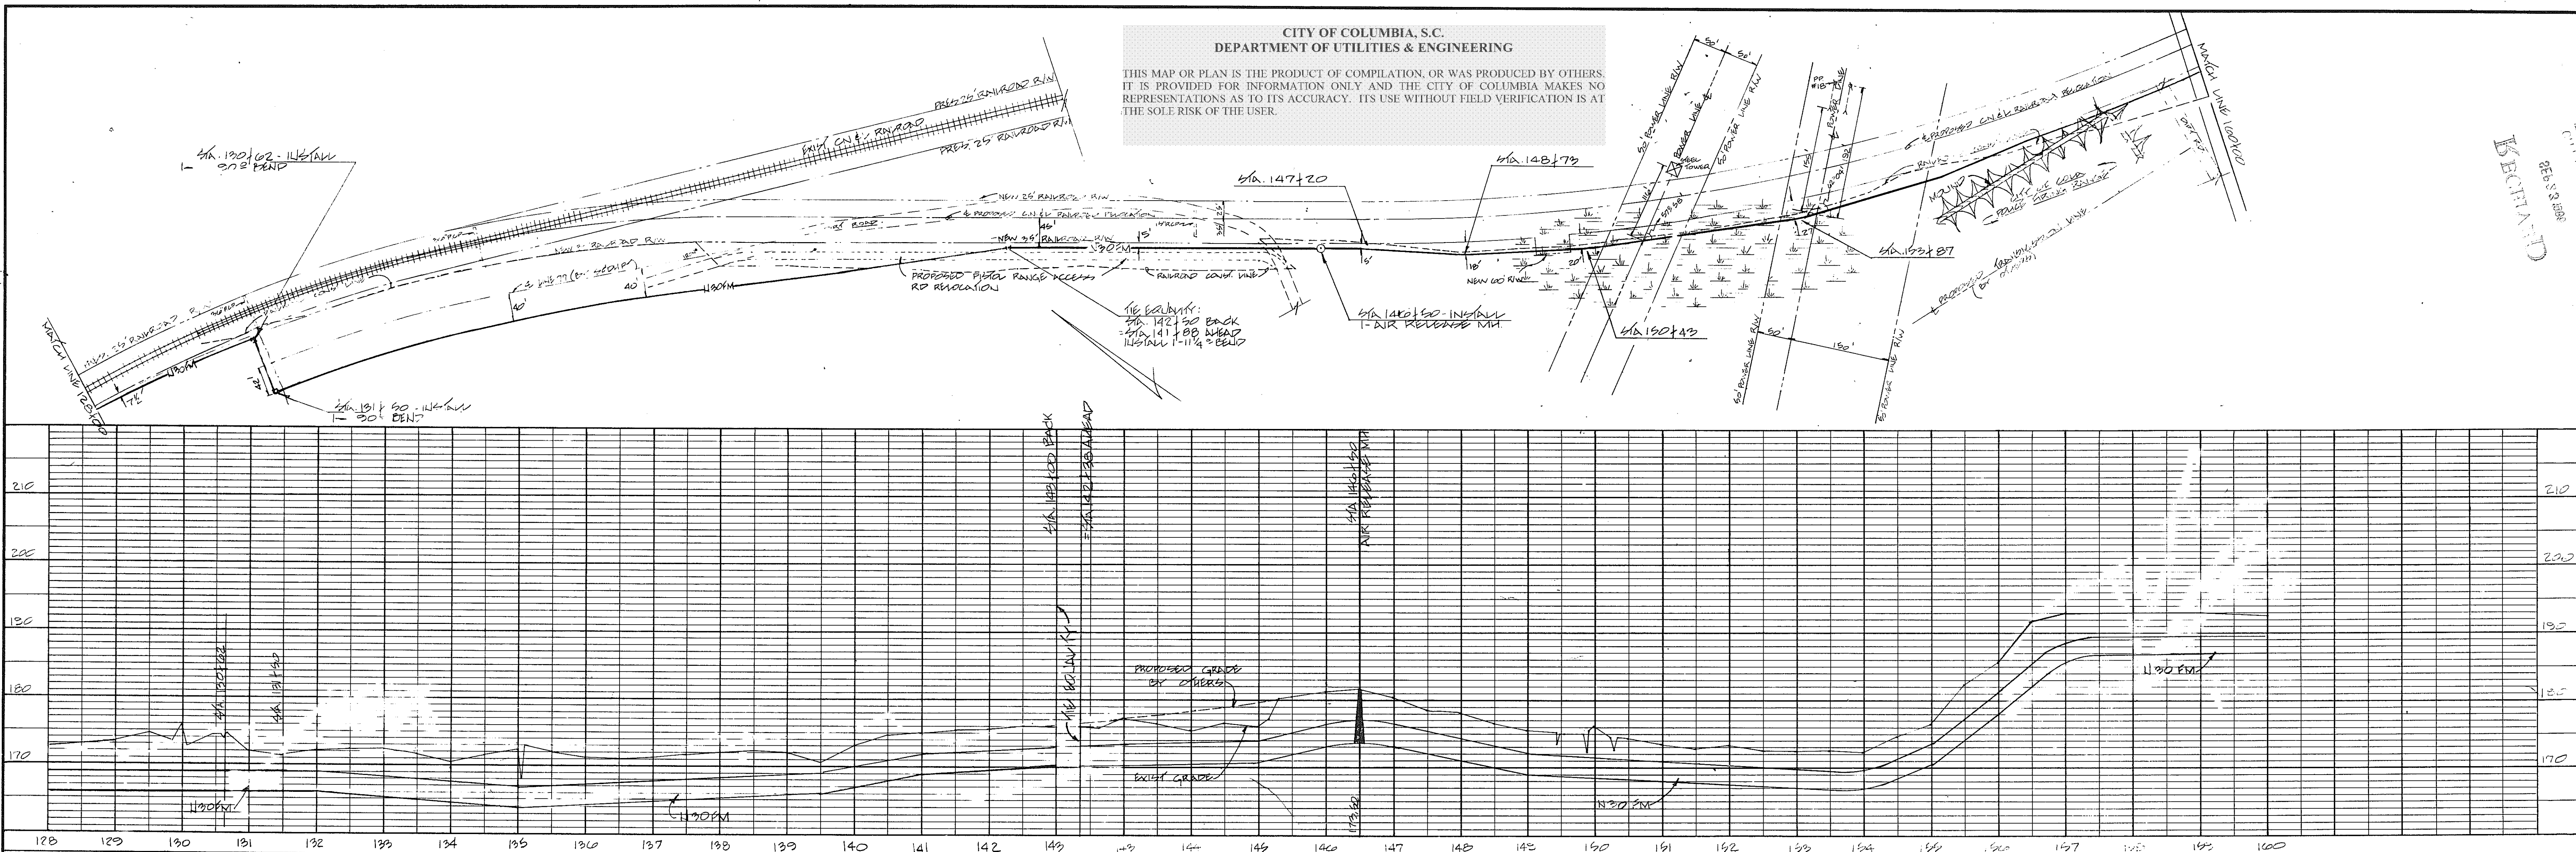

DESIGNED JCR TRACED JCR CHECKED PEM		REVISIONS MAY 1973 JUN 1973 JUN 1974 REV 142+00-171+00 FEB 1984	ADDITIONS TO SANITARY SEWER SYSTEM CITY OF COLUMBIA COLUMBIA, S.C. SALUDA RIVER KINLEY CREEK INTERCEPTORS DIVISION ONE "AS-BUILT" SCALE: 1"=100' HORIZONTAL, 1"=10' VERTICAL DATE: JUNE 1977	SHEET NO. 5 OF 14 SHEETS NOTEBOOK NO. 22-02-49 FILE NO.
---	--	--	--	--

60-32