


NOTE:
 THIS MAP IS BASED ON CONSTRUCTION PLANS PREPARED FOR
 MACALLOY PROPERTY STORMWATER MANAGEMENT PLAN
 BY GENERAL ENGINEERING & ENVIRONMENTAL, LLC - DATED 01/28/05.

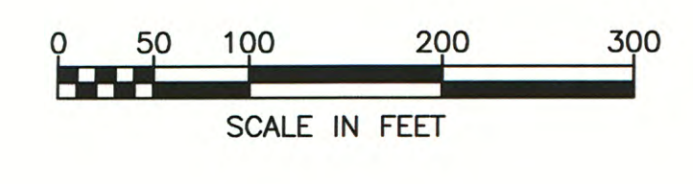

ENSAFÉ	
<small>AN ASSOCIATE OF THE ENVIRONMENTAL GROUP 200 WEST 10TH STREET, SUITE 200 CHARLESTON, SOUTH CAROLINA 29401 TEL: 803.733.1111 FAX: 803.733.1112 WWW.ENSAFE.COM</small>	
FIGURE 7-3 STORMWATER MANAGEMENT PLAN DESIGNED FOR SITE REDEVELOPMENT REMEDIATION ACTION REPORT MACALLOY CORPORATION SITE	
Drawn by: W. FAULK / GEL	Modified by: -
Checked by: C. TRAPP	Appr. by: J. SPICEMAN
Date: 07/31/06	DWG Name: 2417023010234
Sheet 1	of 1