

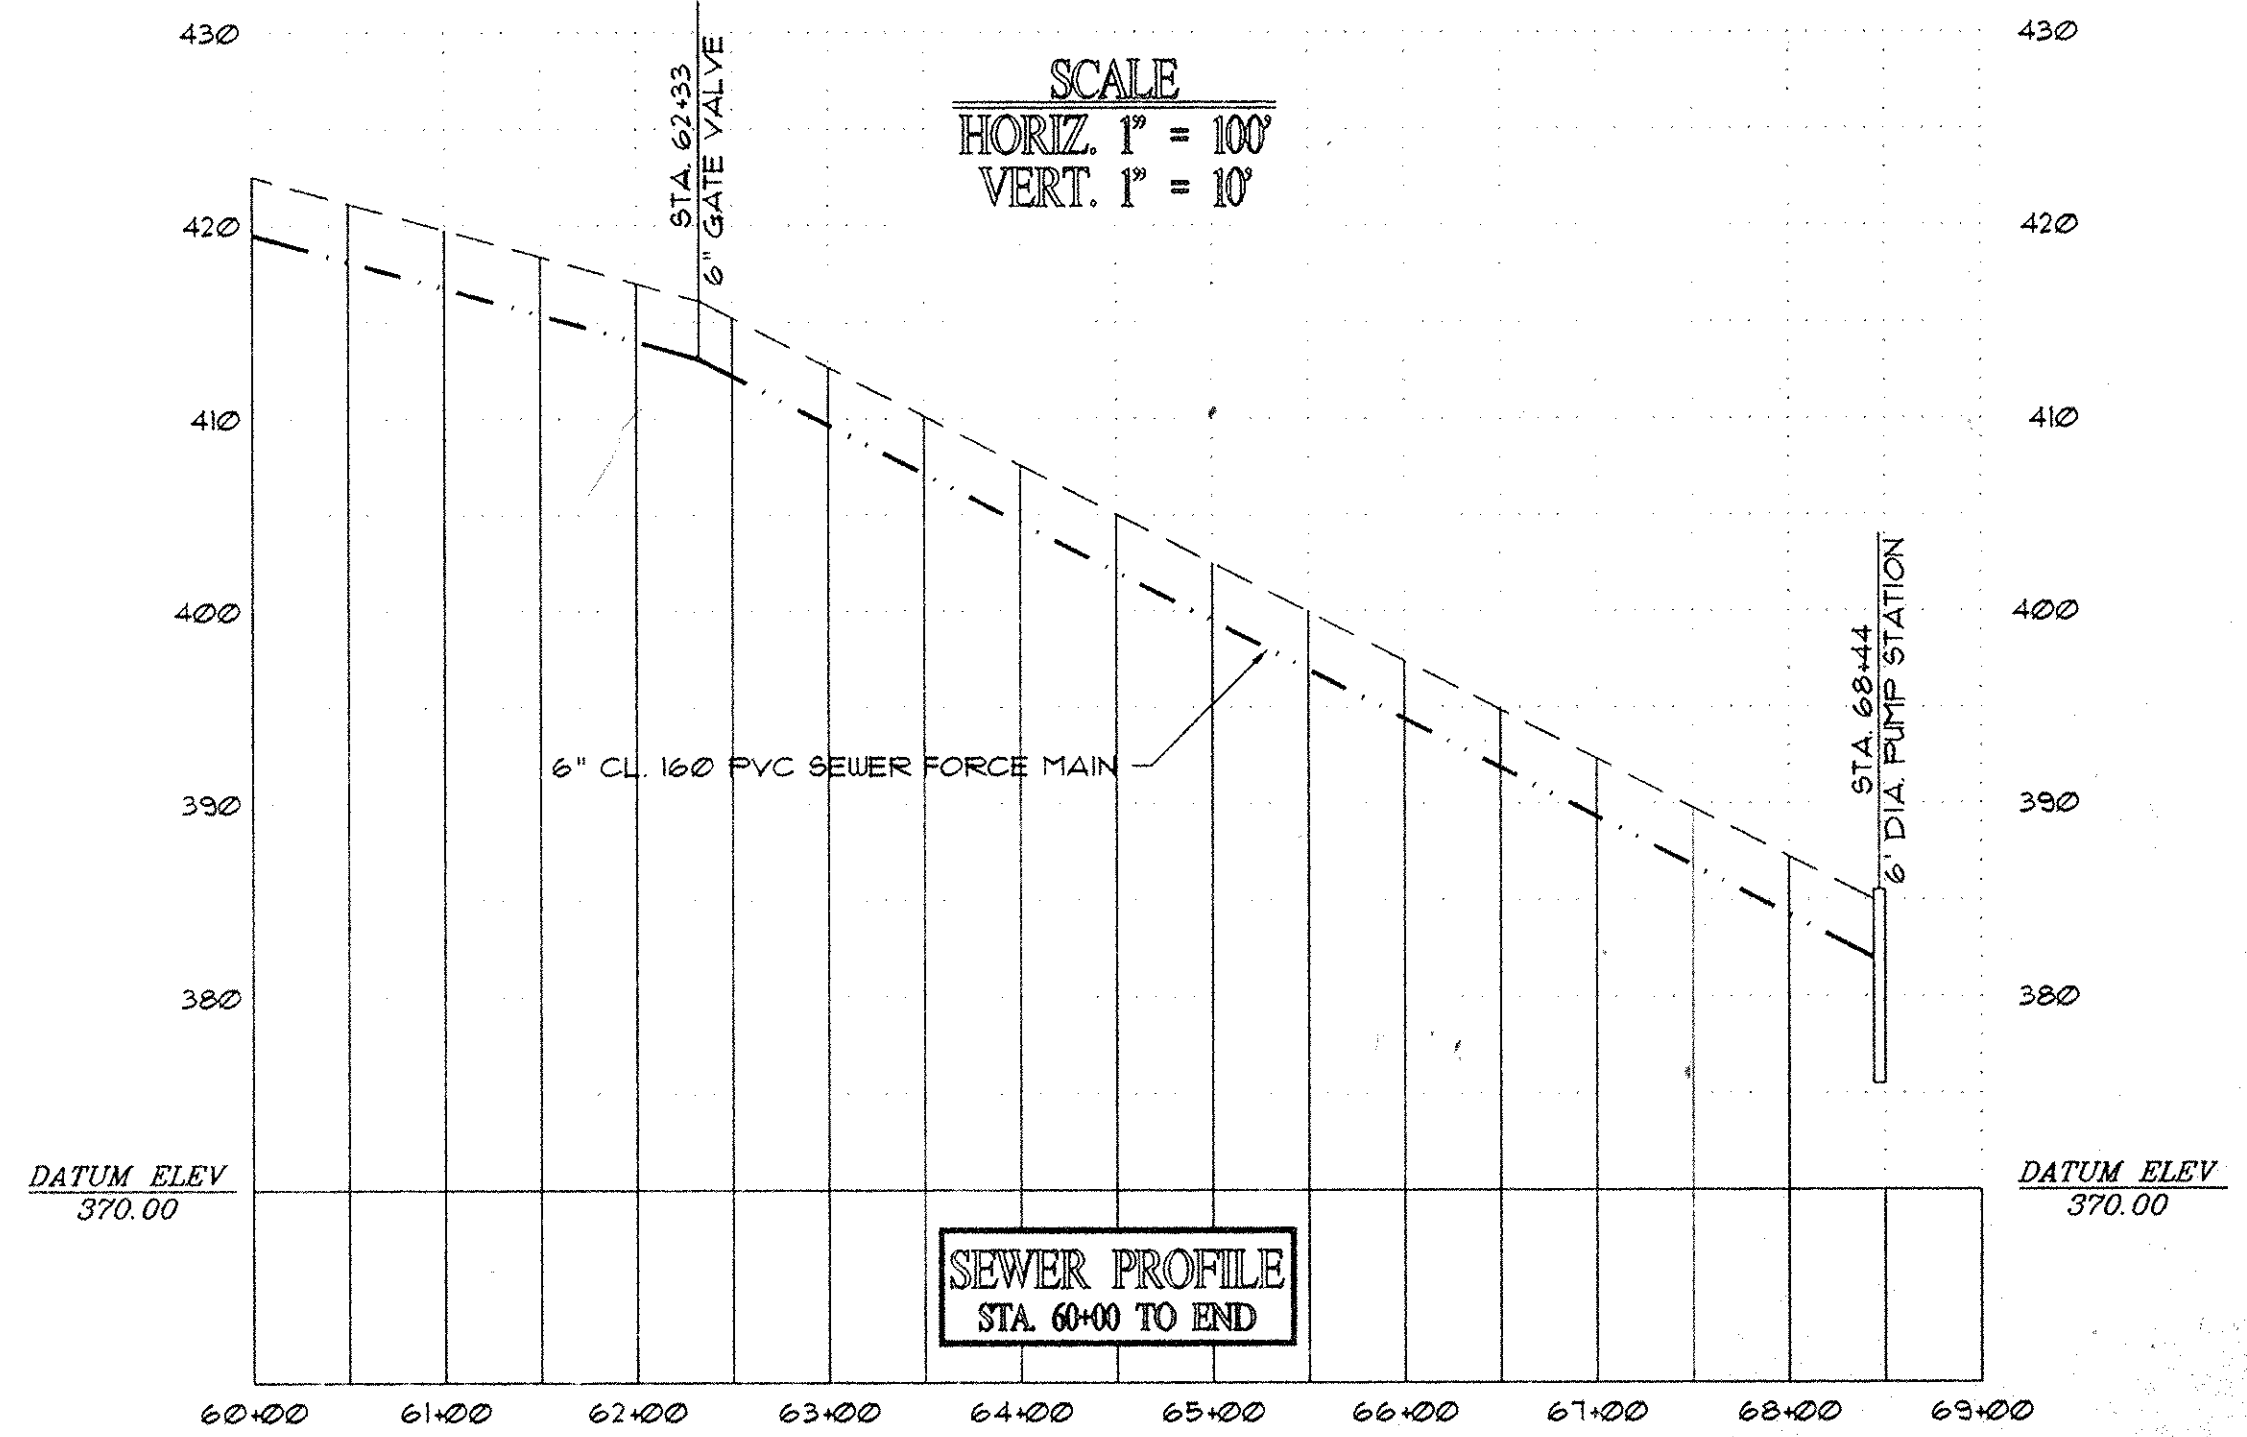



All water line easements for this project from the start at the existing 8" gate valve to the master meter pit are dedicated exclusively to the City of Columbia. All water line easements after the master meter pit extending to the end of the line at I-26 are dedicated exclusively to the Town of Chapin.

TMS # 0300-04-11

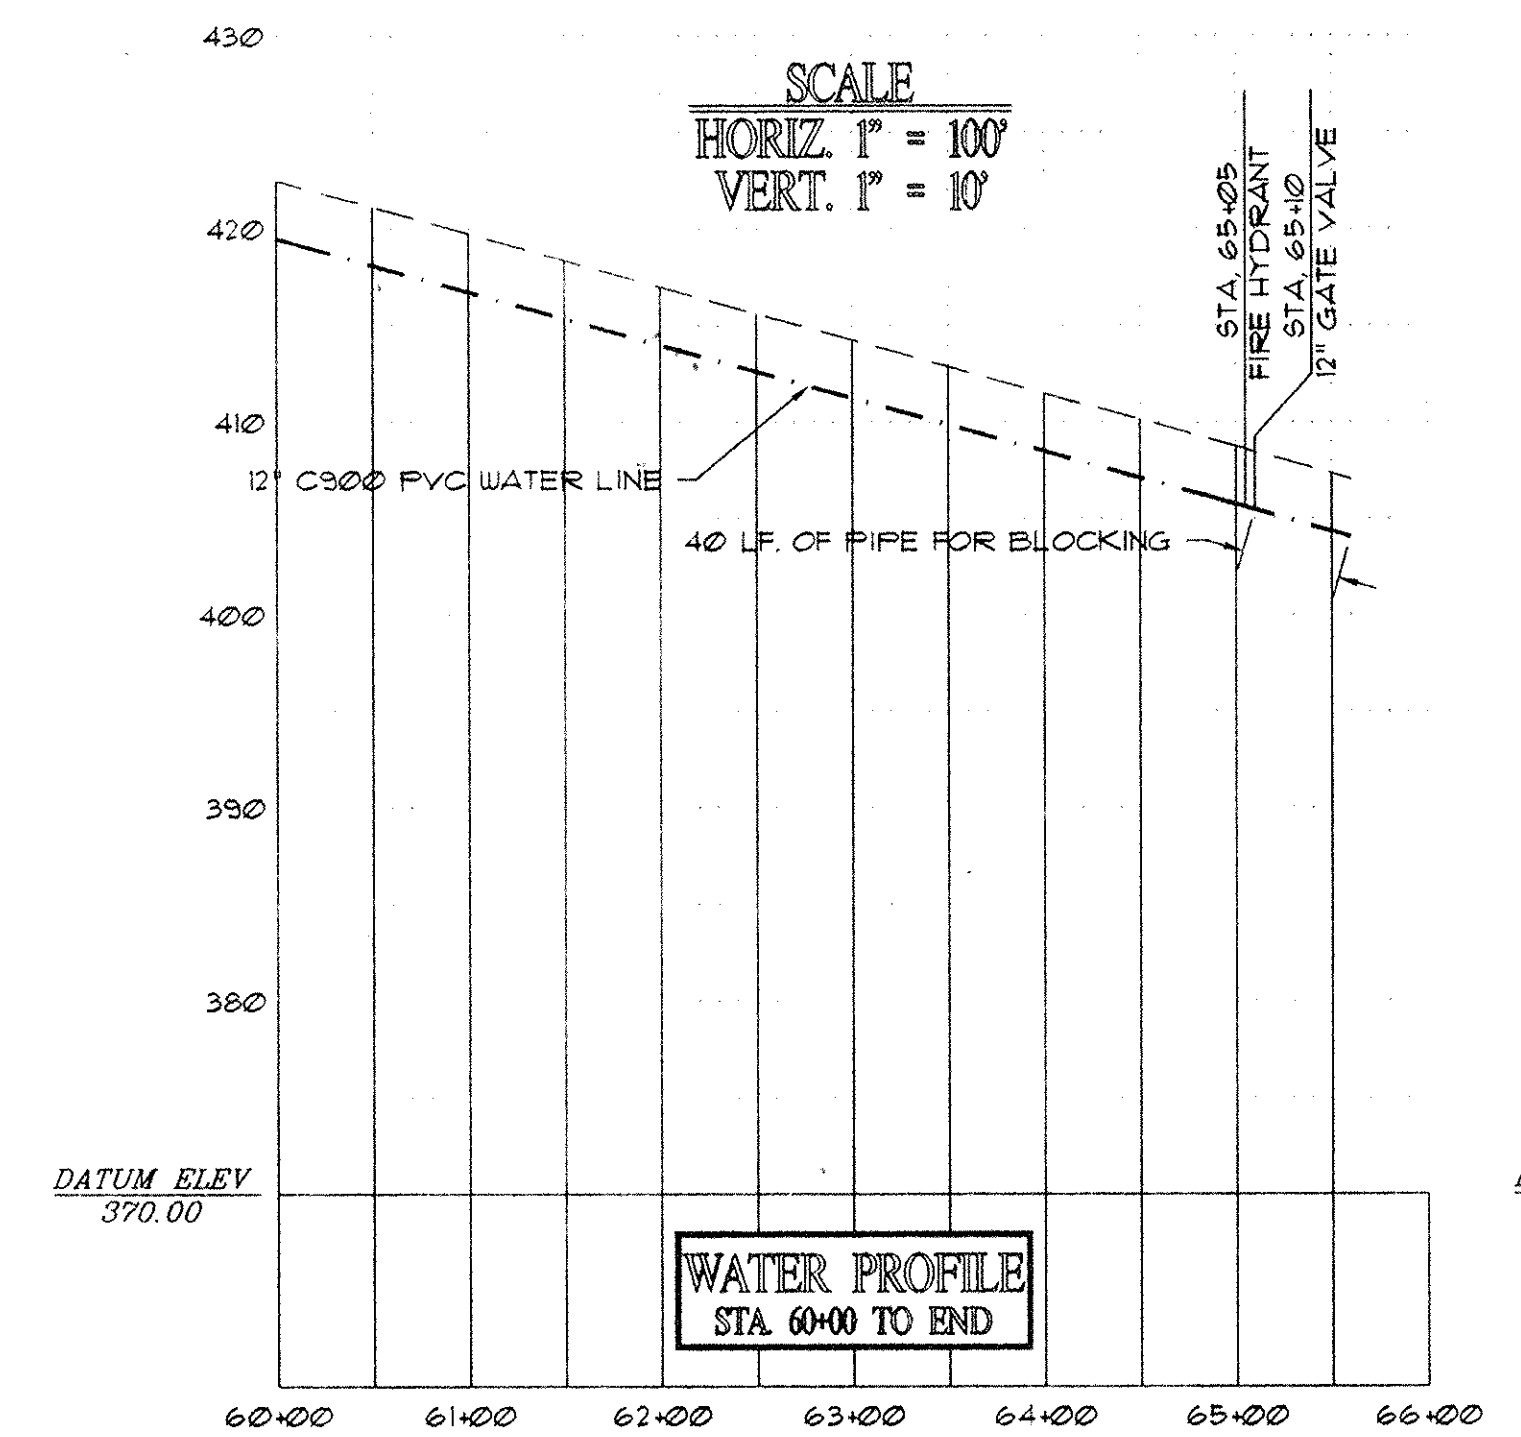

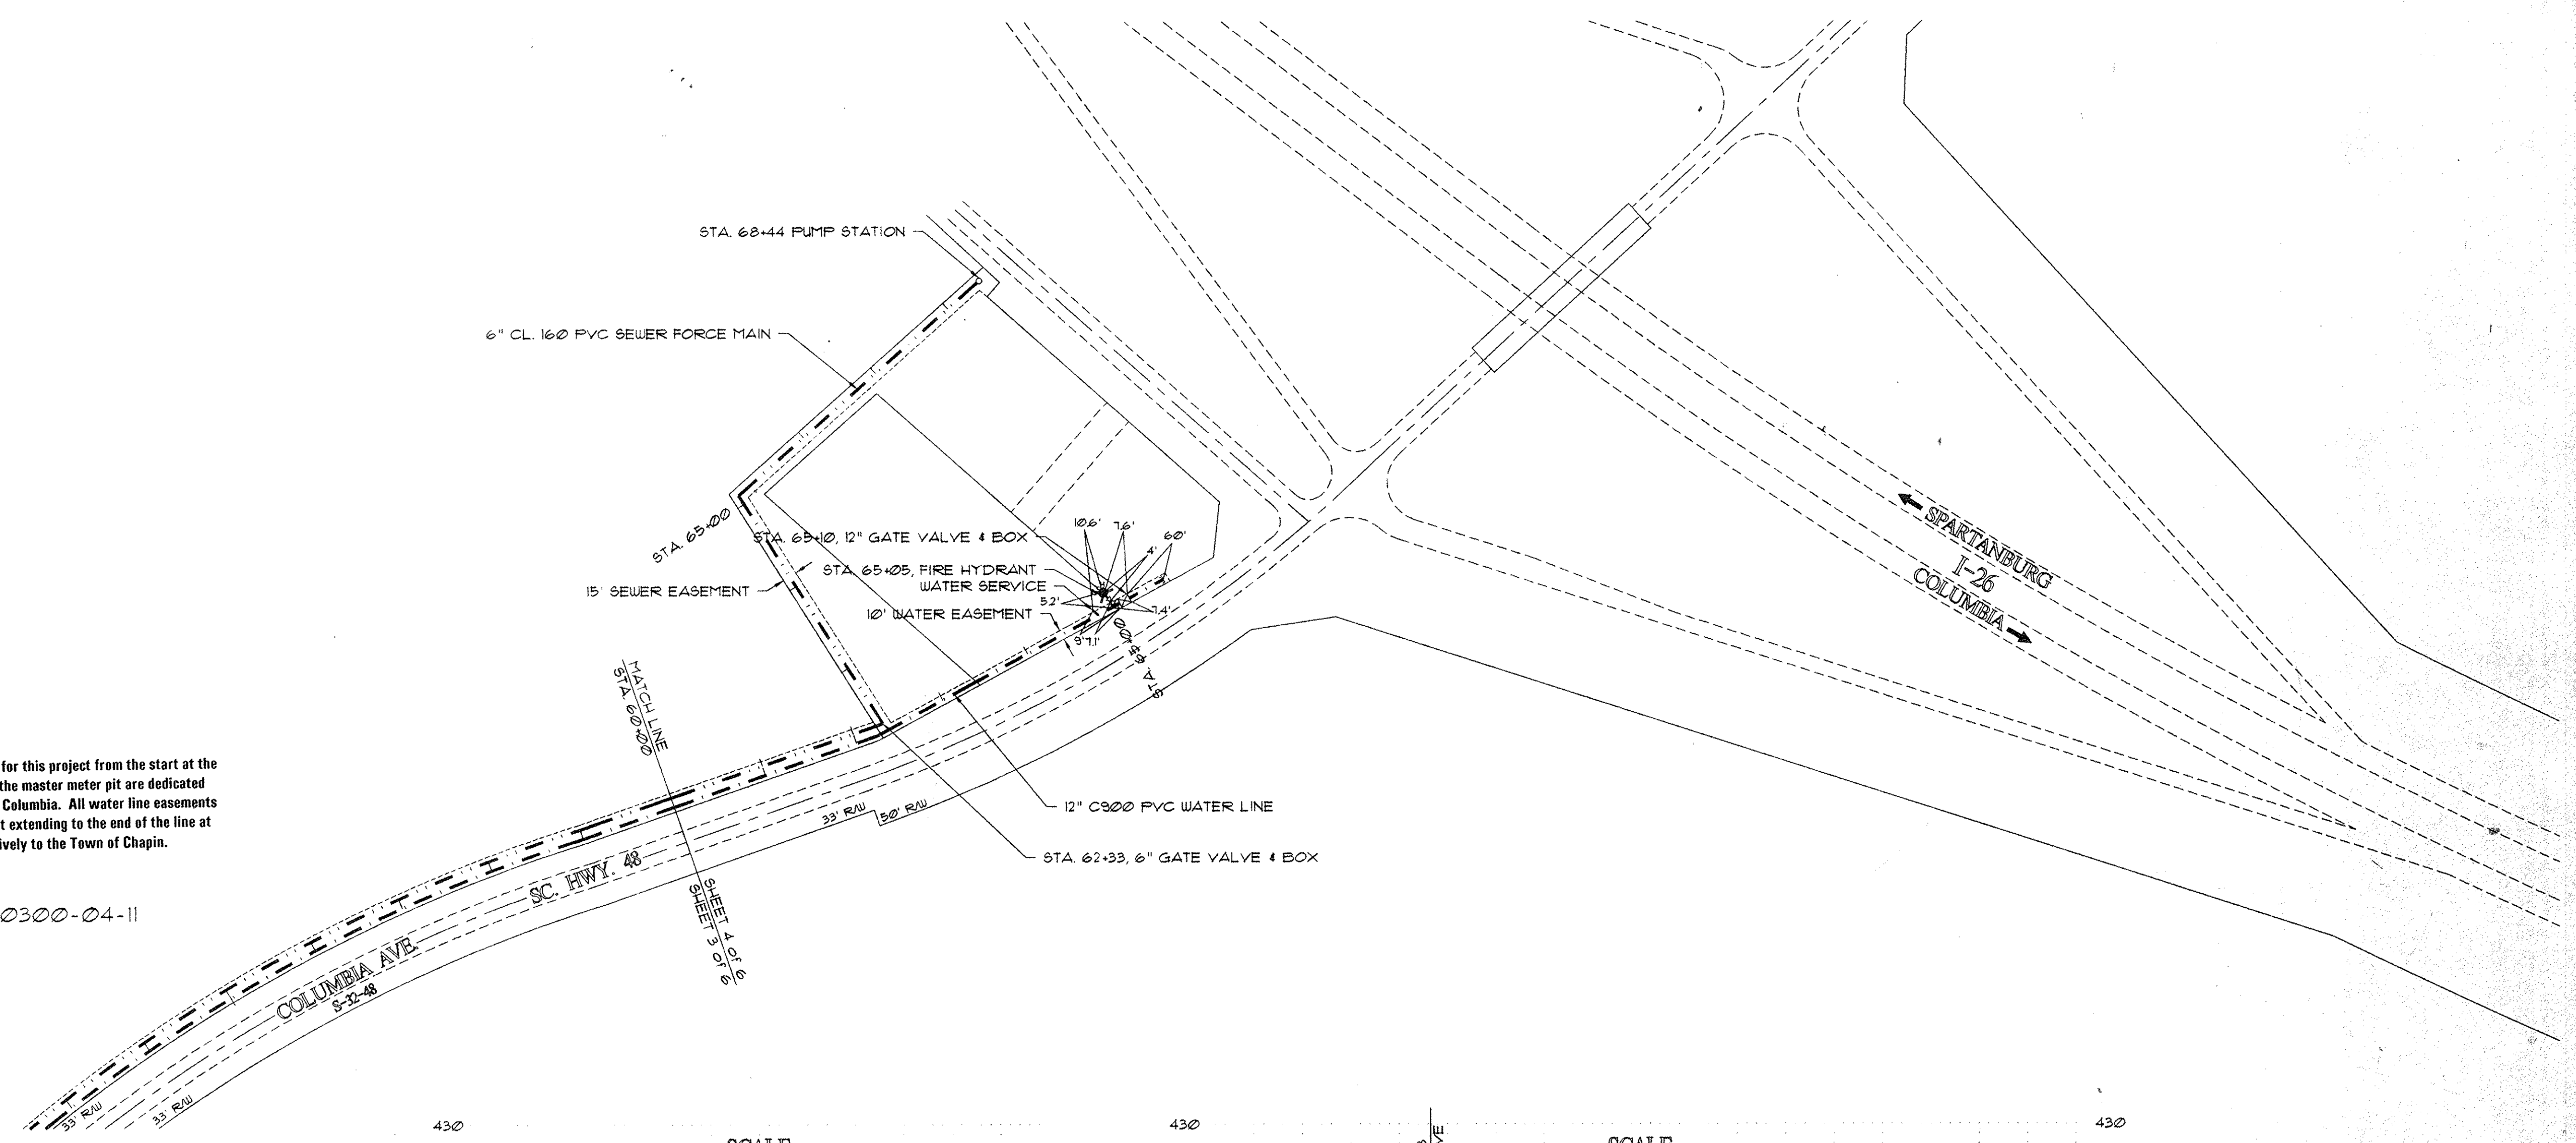

LETTS inc.
DESIGNERS & BUILDERS


(803) 781-9013
7525 BROAD RIVER RD.
P.O. BOX 1488
IRMO S.C. 29063

PREPARED FOR
TOWN OF CHAPIN
MAYOR STAN SHEALY
ATTN: JAY NICHOLSON 345-2444

TITLE
US. HWY. 48 & I-26
WATER EXTENSION
AS-BUILTS
LINE PLAN & PROFILE

NO.	REVISIONS	DATE	BY
1.	ADDED AS-BUILT INFORMATION	10/4/96	WNB

COPYRIGHT
LETTS inc.
THIS DRAWING IS THE
PROPERTY OF LETTS inc.
UNAUTHORIZED USE OF ANY
KIND, INCLUDING USE ON
OTHER PROJECTS, IS
PROHIBITED

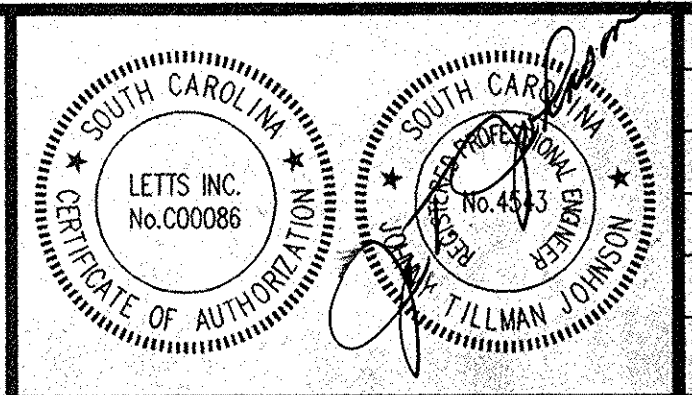

DESIGNED BY:	JTJ
DRAWN BY:	WNB
CHECKED BY:	WNB
APPROVED BY:	JTJ
DATE:	MARCH 1996
PROJECT NO. C-528	SHEET NO. 3 of 3

FOR INFORMATION C5284WAB.DWG

183-ISA