

FED. ROAD DIST. NO.	STATE	COUNTY	FILE NO.	PROJECT NO.	ROAD/ROUTE NO.	SHEET NO.	TOTAL SHEETS
3	S.C.	YORK	46,191B	03-007B/E	S.C.274	1	98

PIN NO. 33304

CONSTRUCTION PLANS

As-Built

INDEX OF SHEETS

SHEET NO.	DESCRIPTION	SHEET SUBTOTALS
1	TITLE SHEET	1
2-2A	SUMMARY OF ESTIMATED QUANTITIES	2
2B	MOVING ITEMS	1
3-3C	TYPICAL SECTIONS	4
4-4A	RIGHT-OF-WAY DATA SHEETS	2
4B-4C	PROPERTY STRIP MAPS	2
5	CONSTRUCTION NOTES / INCLUSIONS	1
5A-5B	REFERENCE DATA SHEETS	2
5C	PLAN SHEET LAYOUT	1
6-10	PLAN AND PROFILE	8
TCI-TC5	WORK ZONE TRAFFIC CONTROL PLANS	5
PMI-PM7	PAVEMENT MARKING AND SIGNING PLANS	7
UI-UI10	UTILITY RELOCATION SHEETS	10
URI-UR6	WATER LINE RELOCATION SHEETS	6
ECI-EC8	EROSION CONTROL SHEETS	9
XI-X37	CROSS SECTIONS	37

TOTAL SHEETS 98


PLAN AND PROFILE OF PROPOSED STATE HIGHWAY





YORK COUNTY S.C. ROUTE 274 CORRIDOR INTERSECTION IMPROVEMENTS PROJECT NO. 03-007B & 03-007E

ROAD S-81 (ADNAH CHURCH RD.)/S.C. ROUTE 5/ROAD S-102 (EASTVIEW RD.)
ROAD S-998 (ROBERTSON RD.)/ROAD S-243 (NEELY RD.)

PROJECT NO. 03-007B

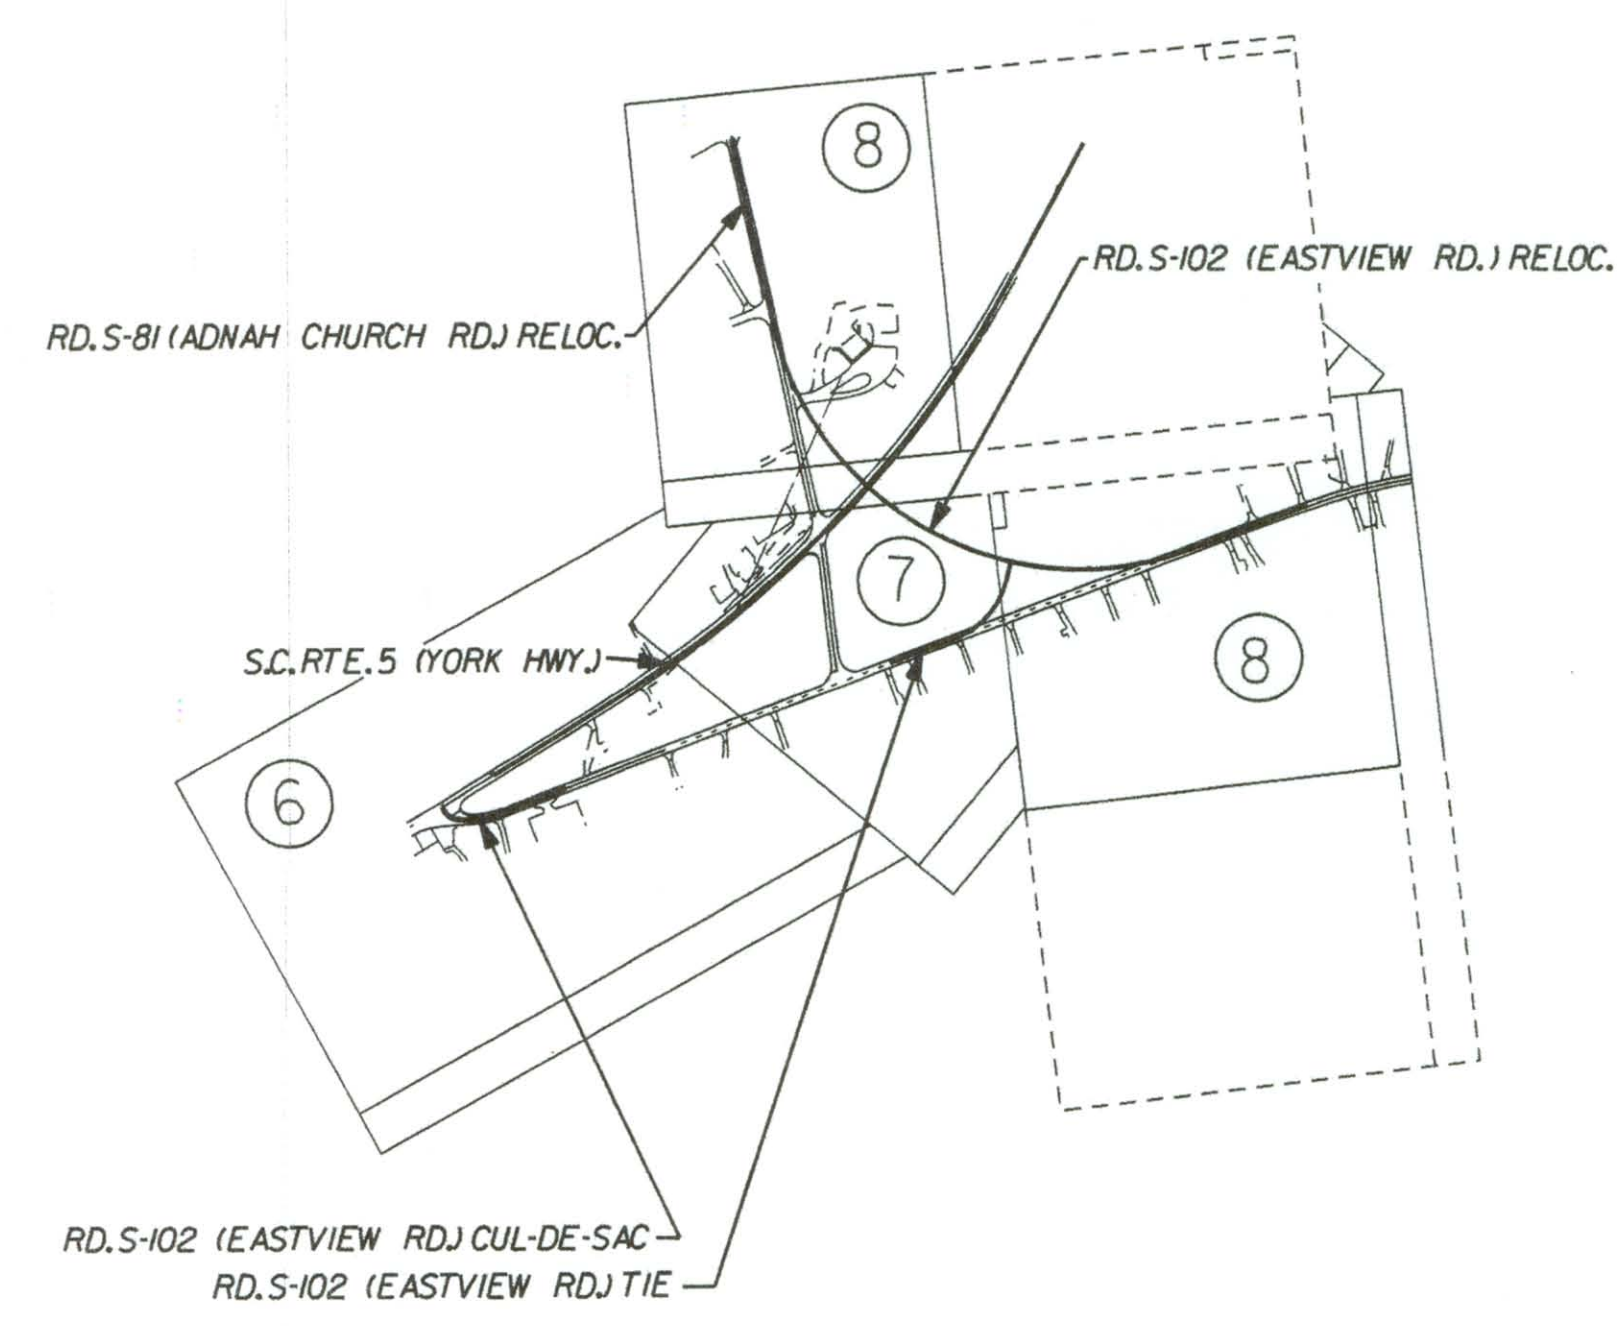

PROJECT NO. 03-007E

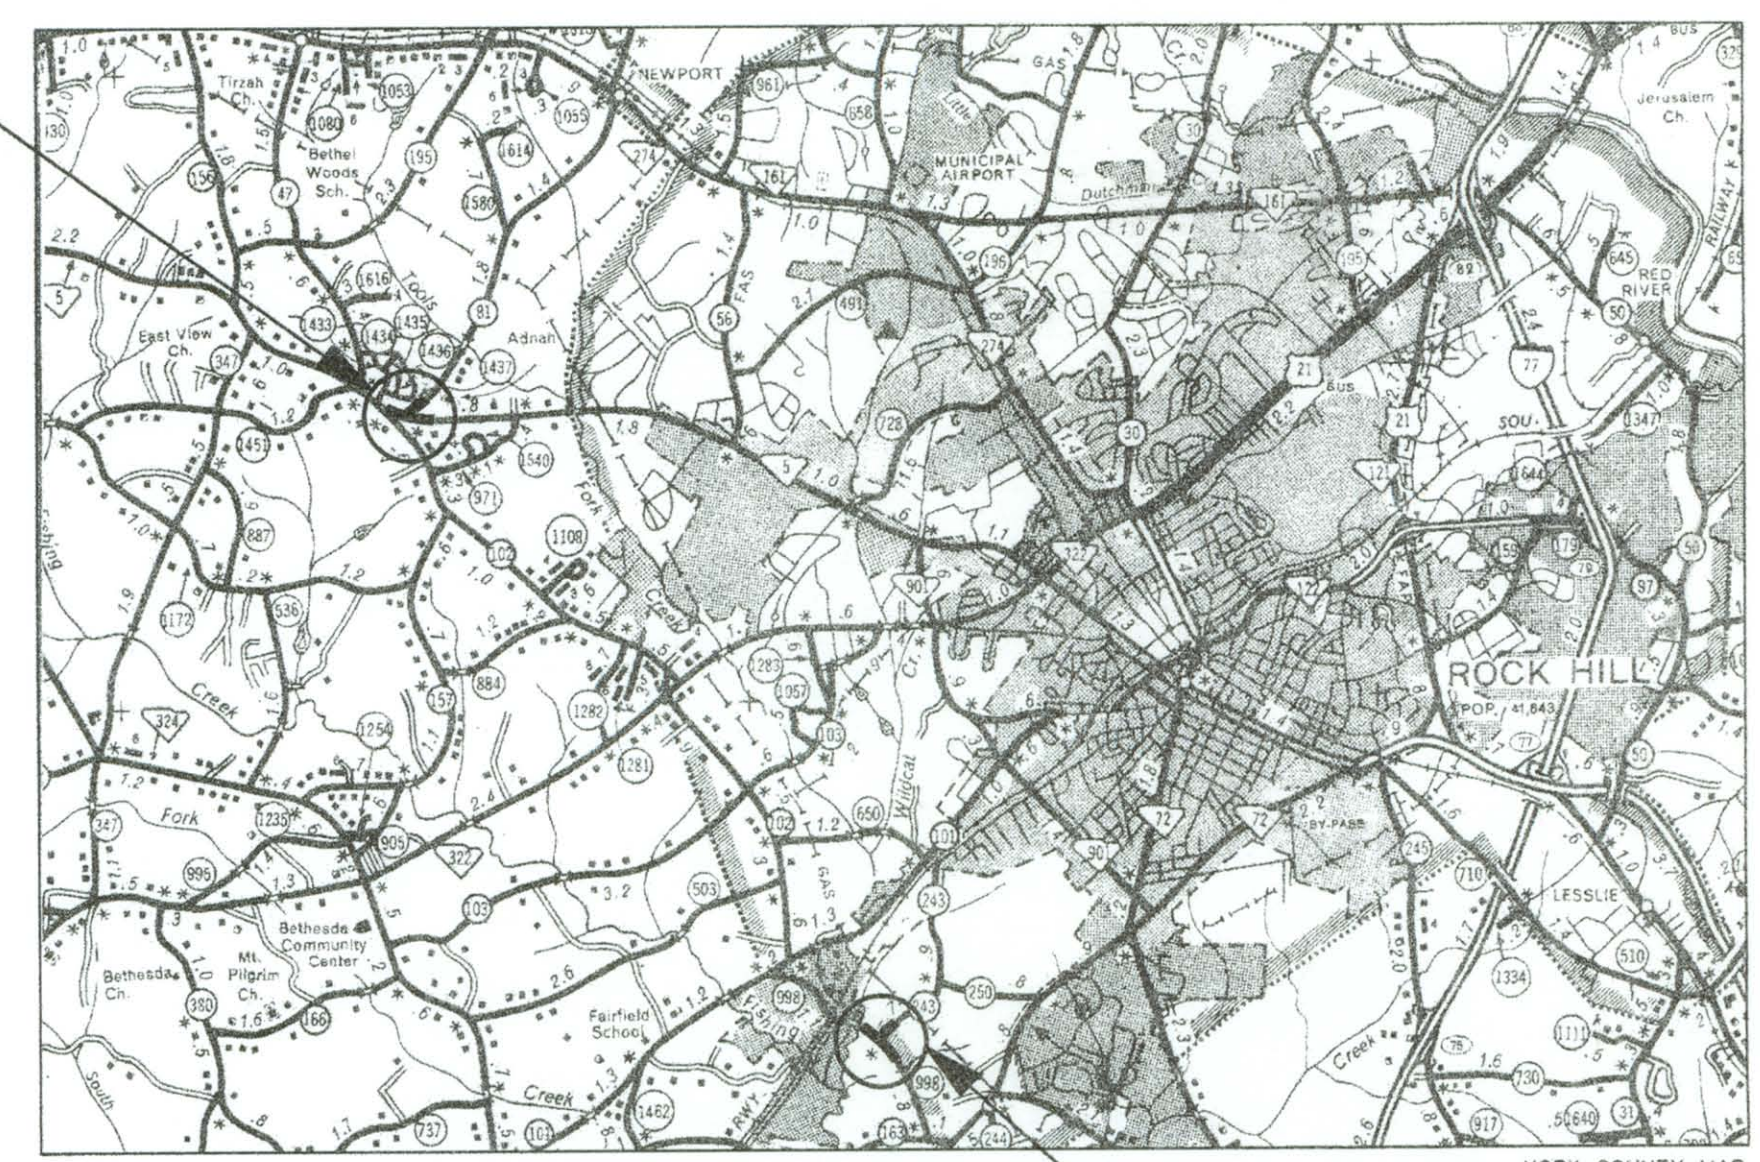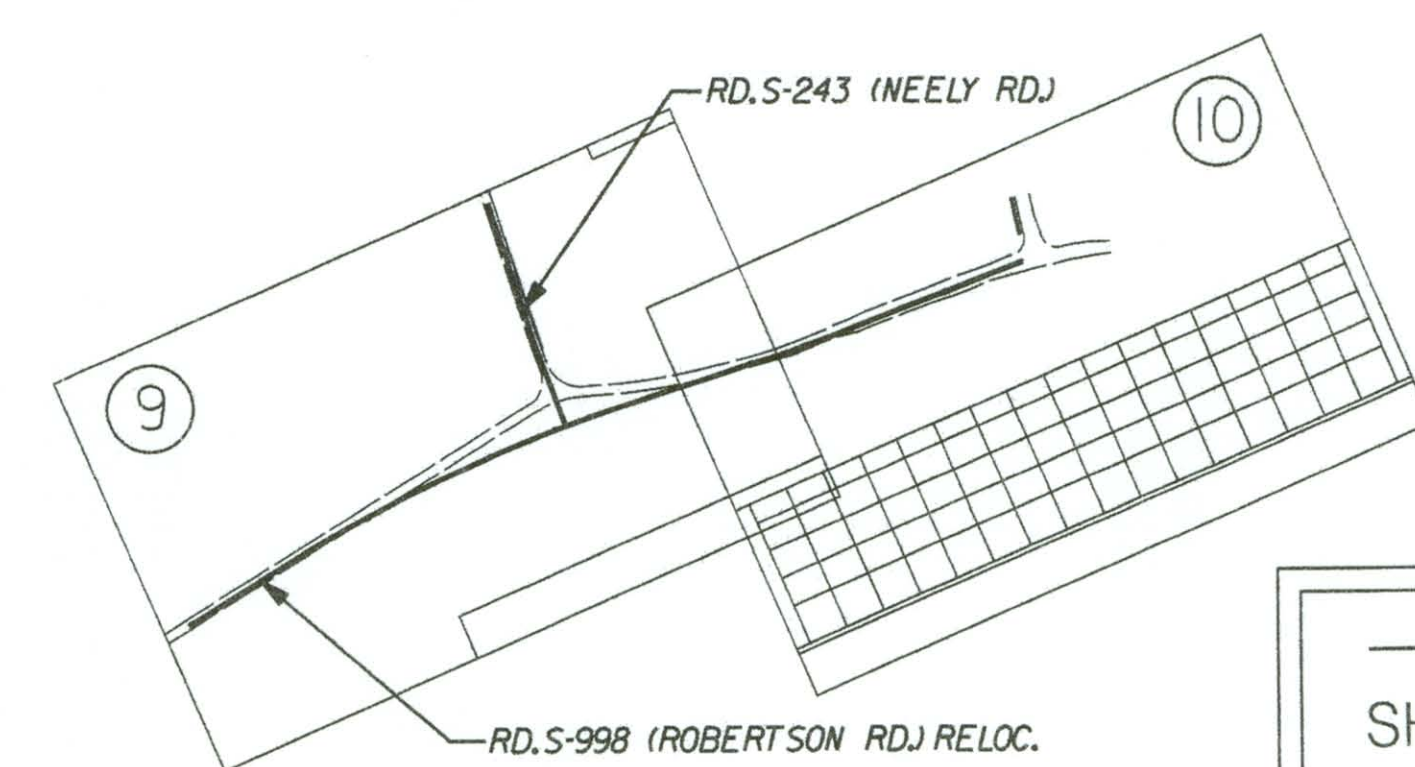

LAYOUT
NOT TO SCALE

INTERSECTION:
PROJECT NO. 03-007E
RD.S-998 (ROBERTSON RD.)
/RD.S-243 (NEELY RD.)

— CONSTRUCTION CHANGE —
SHEET PROVIDED AFTER LETTING

REV. NO.	TAM BY	EJO CKD.	4/12/2010 DATE	ADDED SHEET EC3A DESCRIPTION OF REVISION
----------	--------	----------	----------------	--

NPDES PERMIT INFORMATION			
Project No.	NPDES Disturbed Area (Acres)	Approximate Location of Roadway:	
		Longitude	Latitude
03-007B	8.26	81°07'43"	34°57'22"
03-007E	4.63	81°03'56"	34°53'15"
TOTAL	12.89		

RAILROAD INVOLVEMENT?
YES / NO



CONSULTANT - PROJECT ENGINEER
FOR RIGHT OF WAY: _____
FOR CONSTRUCTION: _____ DATE: 4-12-10

	PROJECT NO. 03-007B				PROJECT NO. 03-007E		
	S.C. RTE. 5	S-81 (ADNAH CHURCH RD.)	S-102 (EASTVIEW RD.)	SIDE ROADS	S-998 (ROBERTSON RD.)	S-243 (NEELY RD.)	TOTAL
NET LENGTH OF ROADWAY	0.332 MILES	0.150 MILES	0.194 MILES	0.111 MILES	0.331 MILES	0.072 MILES	1.190 MILES
NET LENGTH OF BRIDGES	0.000 MILES	0.000 MILES	0.000 MILES	0.000 MILES	0.000 MILES	0.000 MILES	0.000 MILES
NET LENGTH OF PROJECT	0.332 MILES	0.150 MILES	0.194 MILES	0.111 MILES	0.331 MILES	0.072 MILES	1.190 MILES
LENGTH OF EXCEPTIONS	0.000 MILES	0.000 MILES	0.000 MILES	0.000 MILES	0.000 MILES	0.000 MILES	0.000 MILES
GROSS LENGTH OF PROJECT	0.332 MILES	0.150 MILES	0.194 MILES	0.111 MILES	0.331 MILES	0.072 MILES	1.190 MILES

EQUALITIES IN STATIONING:
NONE

TRAFFIC DATA

INTERSECTION	2010 ADT	2030 ADT
ADNAH CHURCH RD./S.C. 5/EASTVIEW RD.	2,450	4,410
ROBERTSON RD./NEELY RD.	1,300	2,440

TRUCKS 5%

NOTE: EXCEPT AS MAY OTHERWISE BE SPECIFIED ON THE PLANS OR IN THE SPECIAL PROVISIONS, ALL MATERIALS AND WORKMANSHIP ON THIS PROJECT SHALL CONFORM TO THE SOUTH CAROLINA DEPARTMENT OF TRANSPORTATION STANDARD SPECIFICATIONS FOR HIGHWAY CONSTRUCTION (2007 EDITION) AND THE STANDARD DRAWINGS FOR ROAD CONSTRUCTION IN EFFECT AT THE TIME OF LETTING.

Design Reference for these plans is the:
2001
AASHTO "A Policy on Geometric Design of Highways and Streets"



"STORM AS-BUILTS ONLY"

PREPARED BY: BER CHK'D BY: JWL REVIEWED BY: DEB

Certification Statement

These plans were prepared and certified by the Consultant for completeness.

No review or signatures by the SCDOT or York County are required.

3 DAYS BEFORE DIGGING IN
SOUTH CAROLINA
CALL 811

PALMETTO UTILITY PROTECTION SERVICES, INC. (PUPS)
ALL UTILITIES MAY NOT BE A MEMBER OF PUPS.

4/12/2010 L:\GEOGRAPHIC B E PLANS\DOT 031110.dgn