


3/30/64

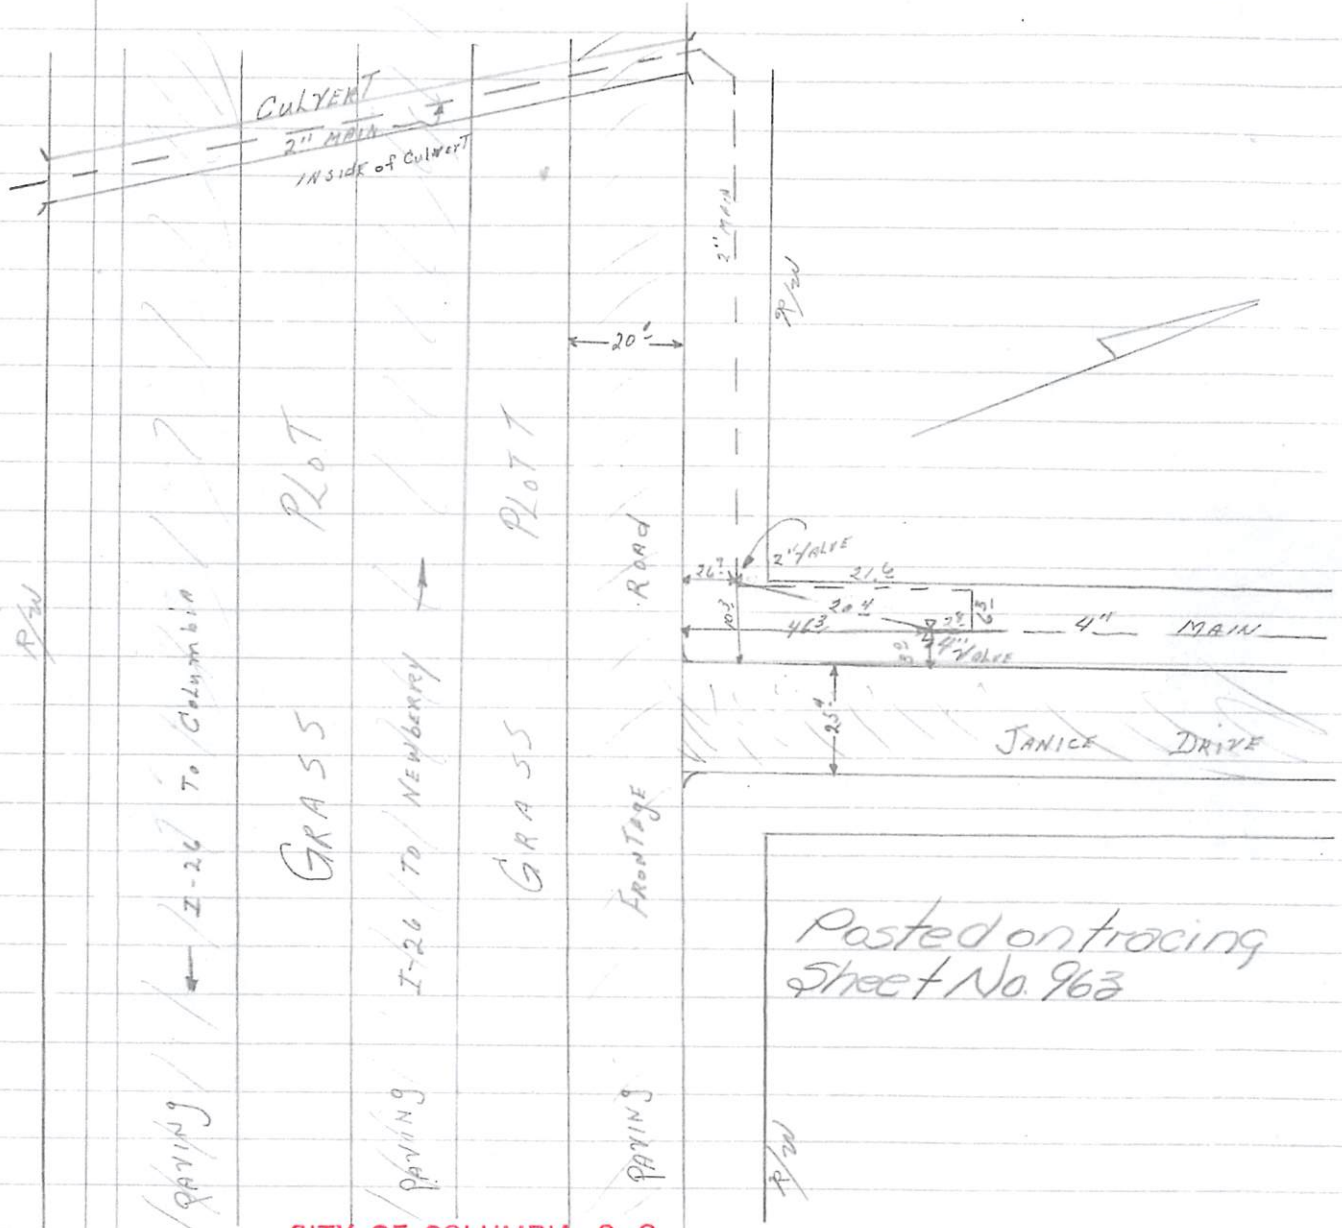

CITY OF COLUMBIA, S. C.

DEPARTMENT OF UTILITIES & ENGINEERING

THIS MAP OR PLAN IS THE PRODUCT OF COM-
PILATION, OR WAS PRODUCED BY OTHERS. IT
IS PROVIDED FOR INFORMATION ONLY AND THE
CITY OF COLUMBIA MAKES NO REPRESENTATIONS
AS TO ITS ACCURACY. ITS USE WITHOUT FIELD
VERIFICATION IS AT THE SOLE RISK OF THE USER

Posted on tracing
Sheet No. 963

P.O.P.