



LOCATION MAP

AS-BUILTS

NOTE:  
WHERE A ROAD BORE IS INVOLVED, A POTHOLE MEASURING APPROXIMATELY 18" X 18" WILL BE NECESSARY TO LOCATE OTHER UTILITIES AND WILL BE REPAIRED TO SCDOT SPECIFICATIONS.

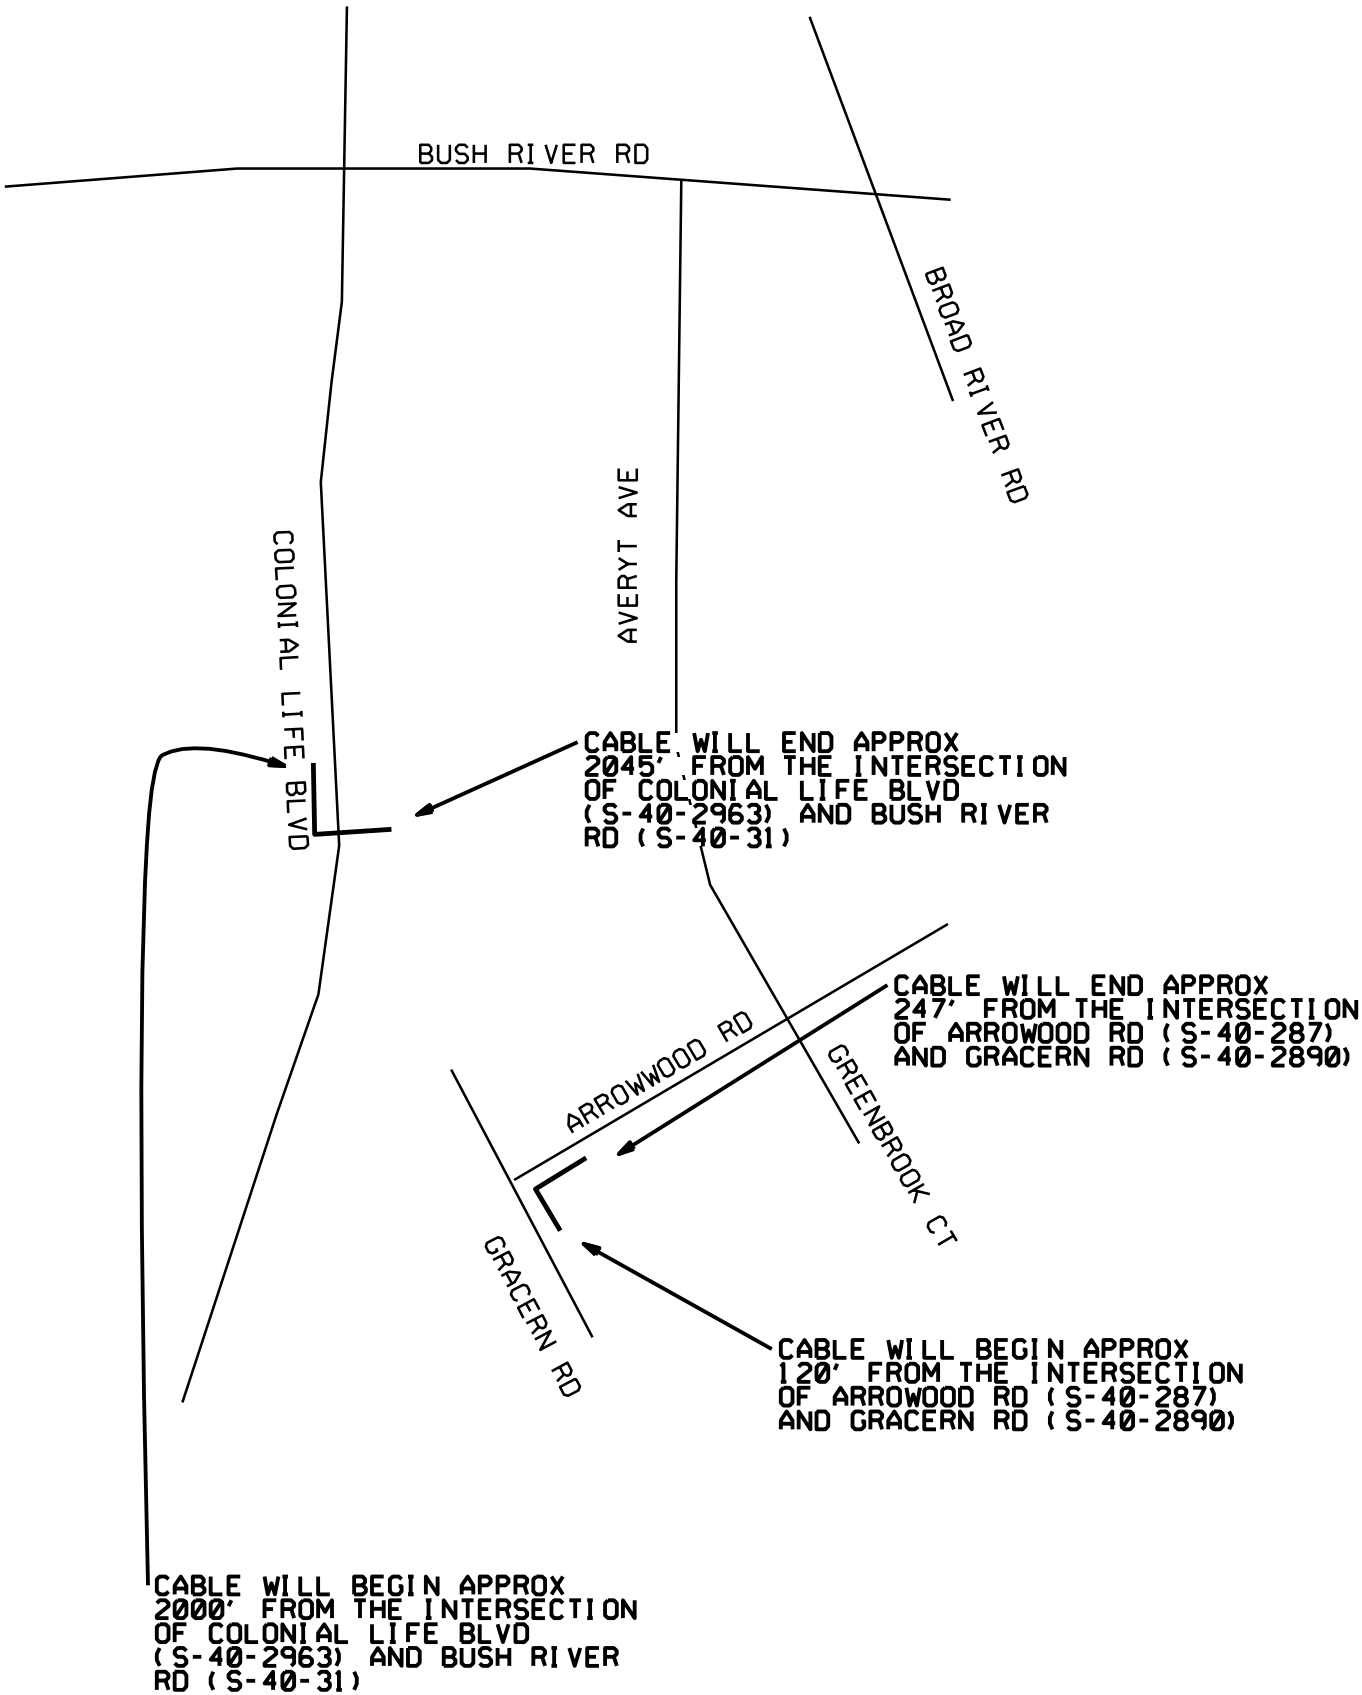

PLACE A SYMBOL ON ROADBORE INDICATING A POTHOLE

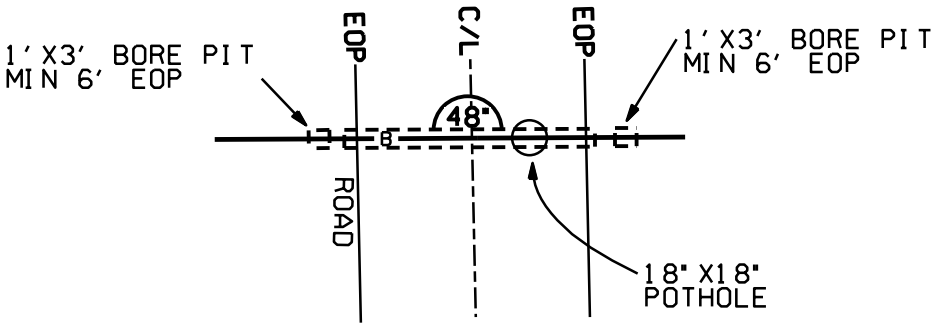

FIBER CABLE SIZE:  
48 FIBERS  
DIAMETER: 0.65"  
  
CONDUIT:  
TYPE: POLYPIPE  
DIAMETER: 1.25"

BURIED SYMBOL LEGEND		
Proposed	Existing	Description
		BURIED CABLE
		BUR JOINT-TRENCH
		ENCLOSURE
		ENCLOSURE
		MANHOLE
		PIPE/CONDUIT
		CABLE MARKER
		BURIED SVC WIRE
		JOINT-TRENCH SVC
	N/A	BORE
	N/A	CUT PAVEMENT
	N/A	SPLICING PIT
	N/A	TRENCH LENGTH/DEPTH

Cable Placement Info:  
Total placement: 495'  
Directional bore: 491'  
Jack and Bore: 0'  
Trench: 4'

Cable depth: 42" unless noted

CALL BEFORE YOU DIG

SOUTH CAROLINA  
DIAL 811 or  
1-888-721-7877  
www.call811.com

TWO FULL BUS. DAYS BEFORE YOU DIG

IT IS THE CONTRACTOR'S RESPONSIBILITY TO CONTACT UTILITY COMPANIES PRIOR TO ANY CONSTRUCTION AS THE LOCATION OF UTILITIES SHOWN ON THIS PLAN ARE APPROXIMATE AND POSSIBLY INCOMPLETE. THEREFORE CERTIFICATION TO THE LOCATION OF ALL UNDERGROUND UTILITIES IS WITHHELD.

PLACEMENT LEGEND

TRENCHED FIBER @ 42"

BORE - SEE DWG FOR TYPE

PIT - SEE DWG FOR TYPE

DITCH LINE

CULVERT

ATTSE

PROPOSED TELEPHONE FACILITIES  
ON RIGHT OF WAY OF  
SCDOT -- RICHLAND

LOCATION MAP

Exchange:  
ST ANDREWS


Designer:  
Rich,Jeffrey

Phone:  
803 476-9277


Authorization:  
89D22667N

Dwg. 1 of 3


COLONIAL LIFE BLVD W:  
EOP TO EOP: 64'  
R/W TO R/W: 80'

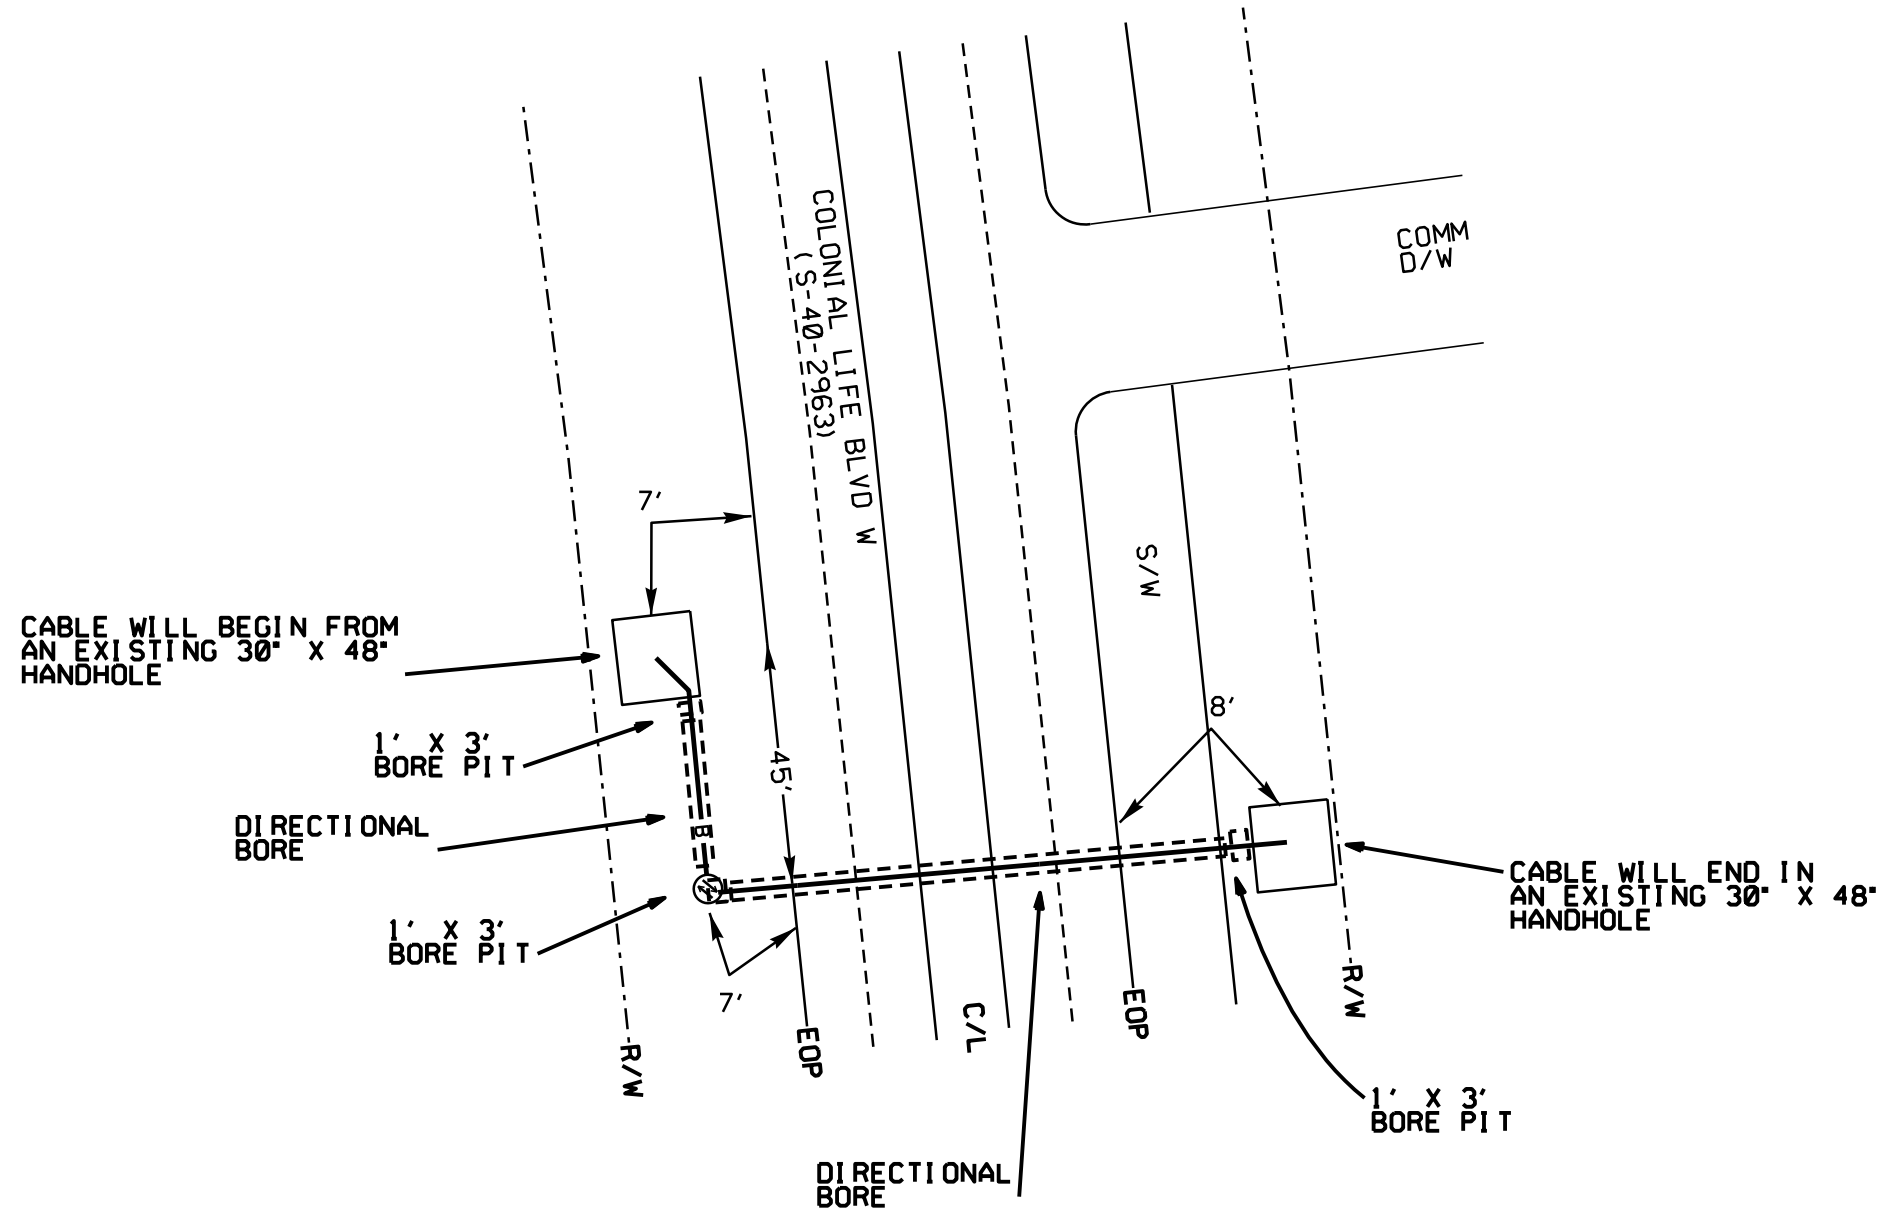

DIRECTIONAL BORE DETAIL

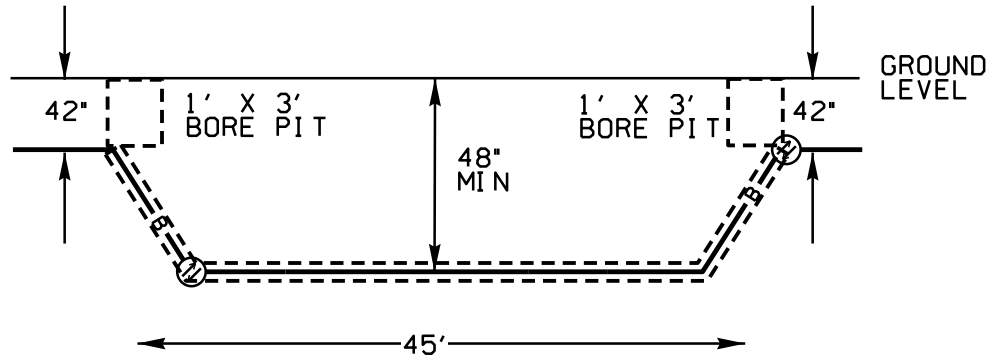

DIRECTIONAL BORE DETAIL

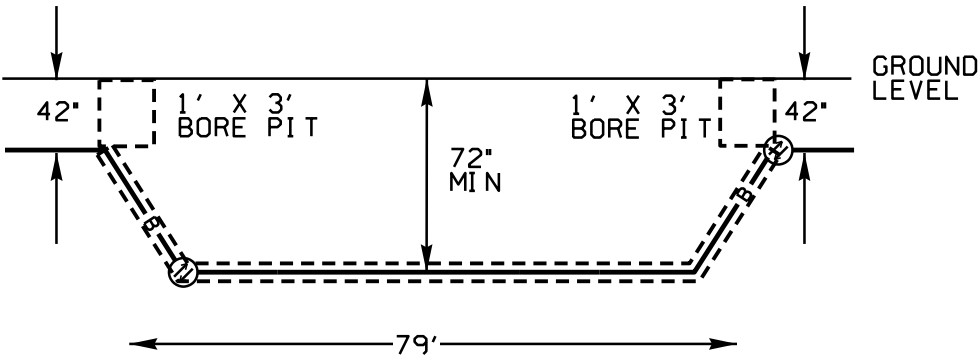


ATTSE	
PROPOSED TELEPHONE FACILITIES ON RIGHT OF WAY OF SCDOT -- RICHLAND	
S-40-2963	
Exchange:	ST ANDREWS
Designer:	Rich, Jeffrey
Phone:	803 476-9277
Authorization:	89D22667N
Dwg.	2 of 3



ARROWWOOD RD:  
EOP TO EOP: 22'  
C/L TO R/W: 50'

GRACERN RD:  
EOP TO EOP: 24'  
C/L TO R/W: 230'

NOTE: GRACERN RD IS  
INSIDE R/W OF I-126

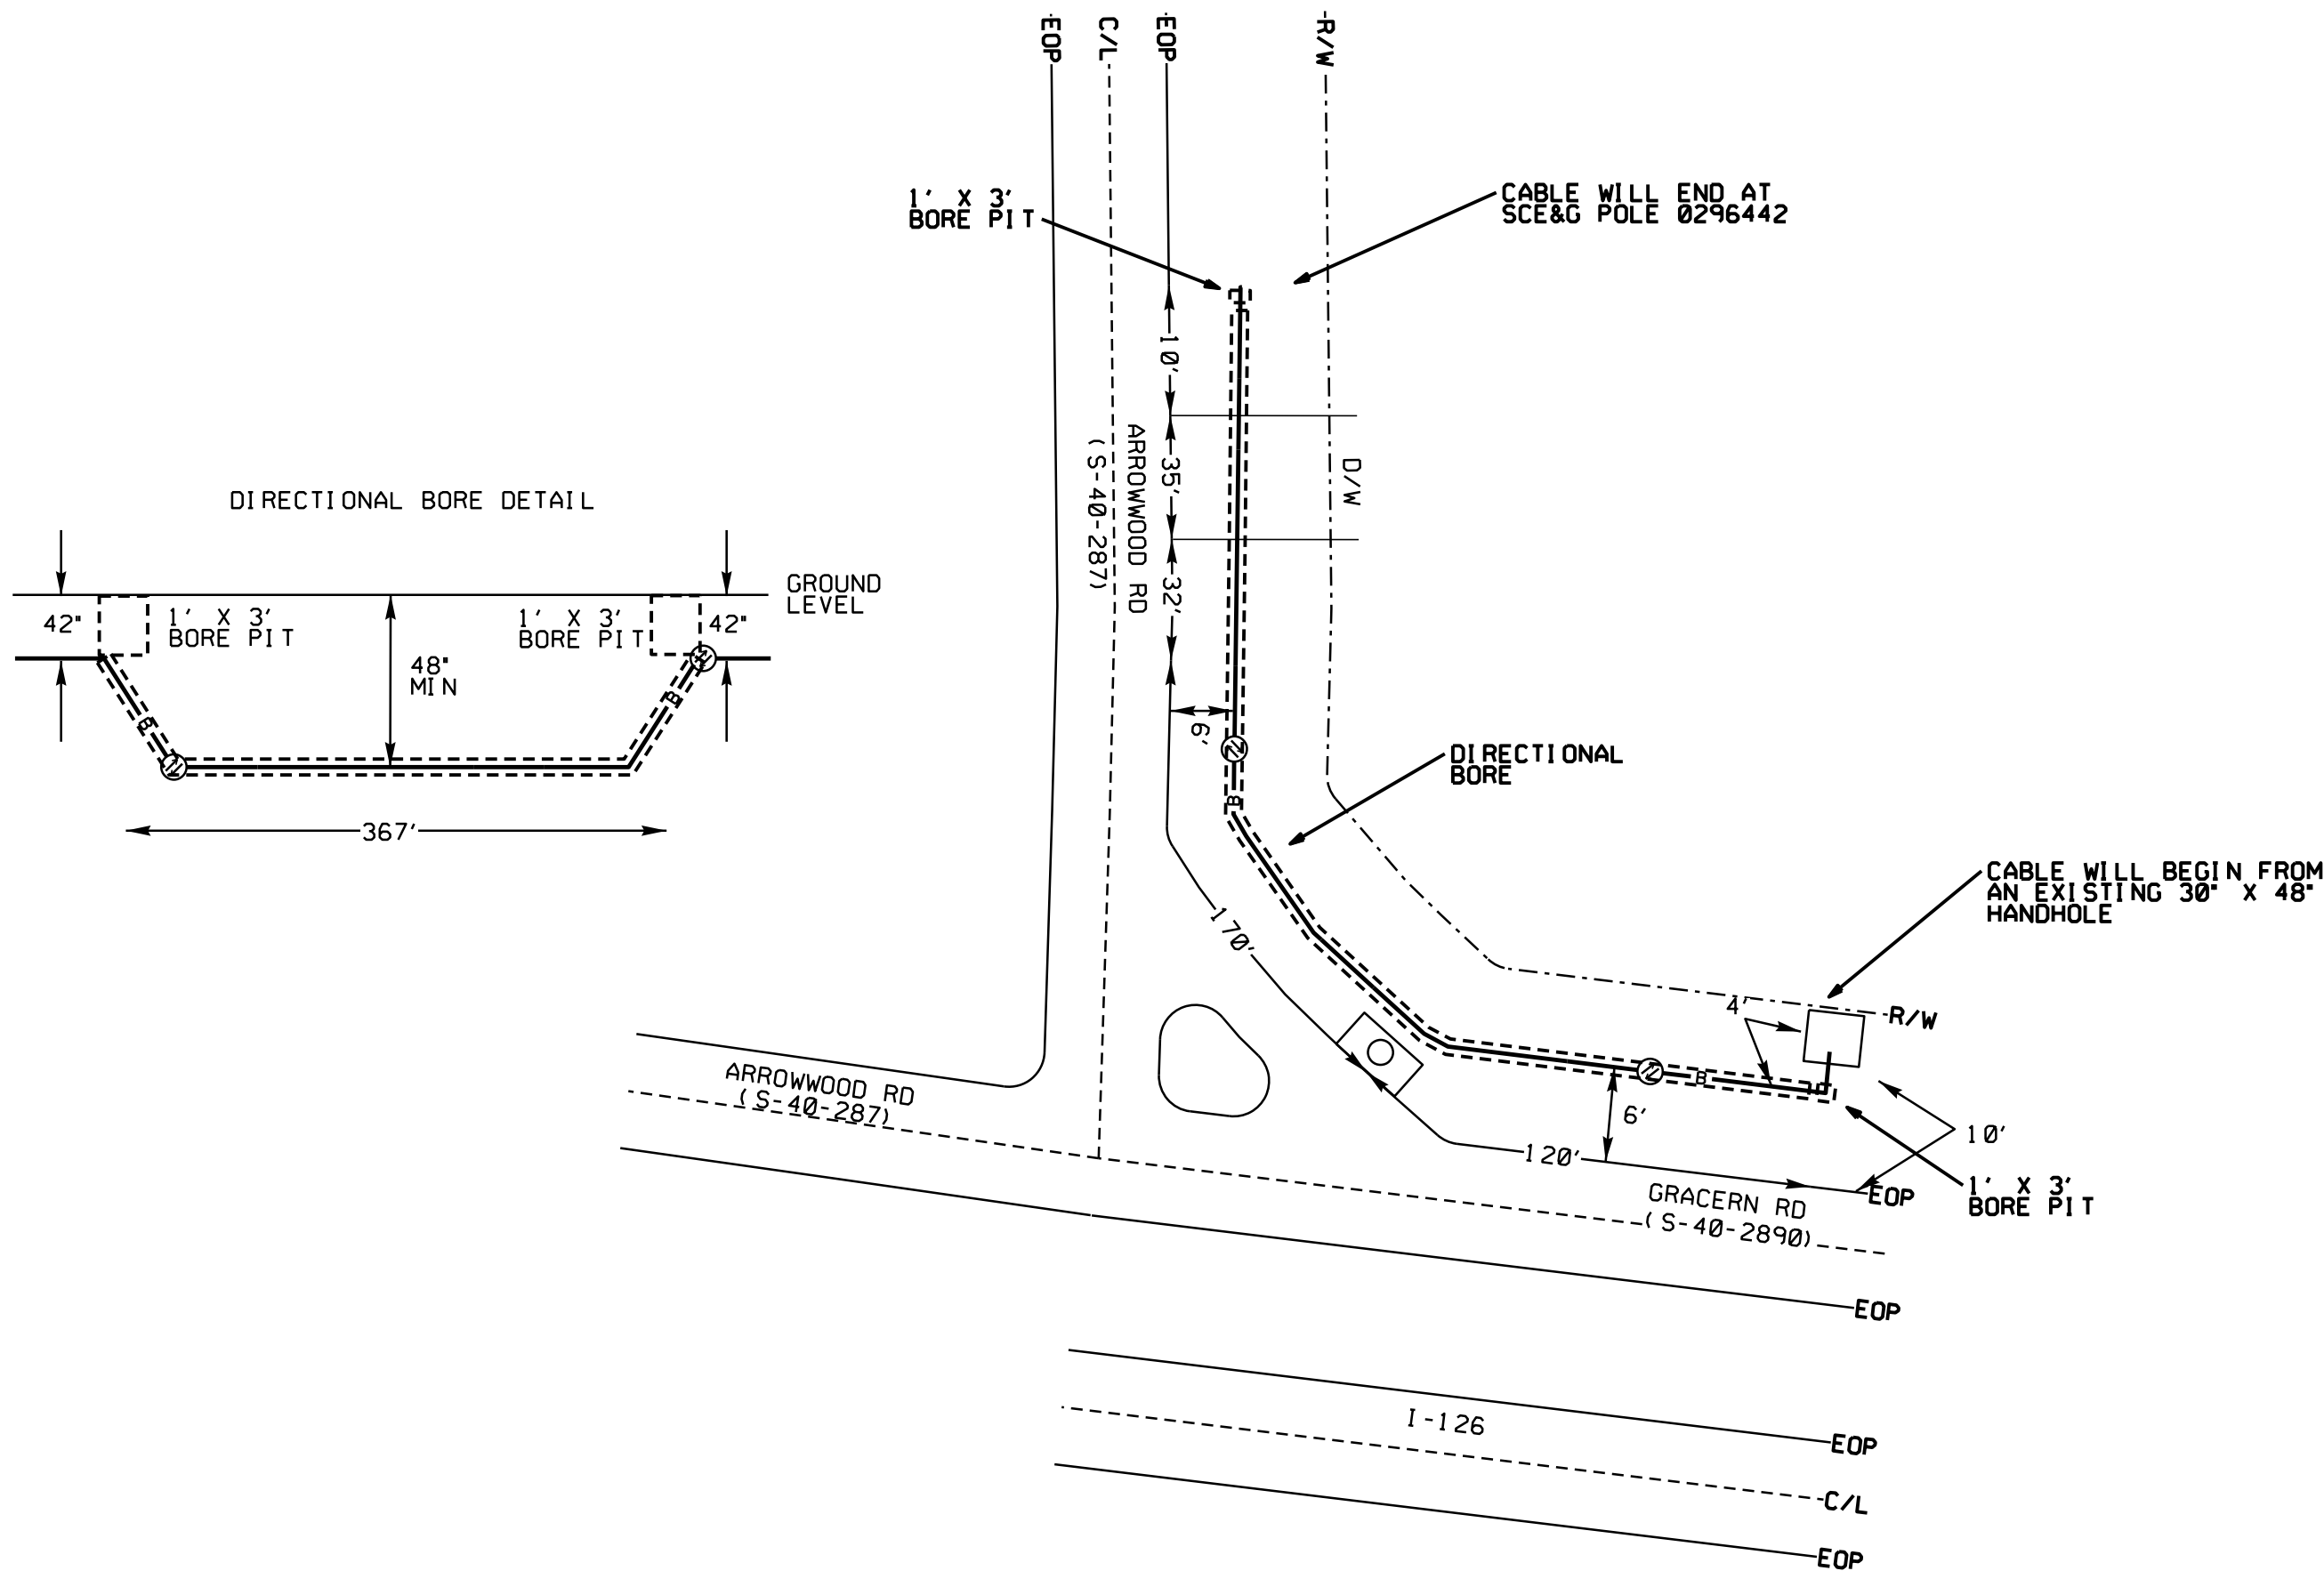

ATTSE	
PROPOSED TELEPHONE FACILITIES ON RIGHT OF WAY OF SCDOT -- RICHLAND	
S-40-2890 / S-40-287	
Exchange:	ST ANDREWS
Designer:	Rich,Jeffrey
Phone:	803 476-9277
Authorization:	89D22667N
Dwg. <u>3</u> of <u>3</u>	