

Date	Conduit Placed Columbia			NFID
12/8/19				1710AIEE.39
Transmedia	Span	Item #	Permit Footage	Actual Footage
FIB:BUR::87000497	OSP:GSPAN::87018917	C-100-DB	2690	2947
Total			2690	2947

SS

CORPORATION

LBIA

1710AIEE.39

RICHLAND COUNTY

PROJECT: CONSTRUCTION



DATE:	PROJECT PHASE:	DESCRIPTION:	CONSTRUCTION NOTE: FOLLOW DETAIL SHEETS FOR PLACEMENT OPERATIONS CONFORMING TO FEDERAL STATE & LOCAL CODES.	LOCATION:	MCI	PROJECT CODE:	TITLE:
10/12/18	DESIGN	CONSTRUCTION		NA MTSO COLUMBIA	METRO ACCESS TRANSMISSION SERVICES CORP.	1710A1EE.39	VES2K 720 GRACERN RD. COLUMBIA
	AS-BUILT						
	REVISED						
	REVISED(2)						
DRAFTED BY: C. EDWARDS		ENGINEER(S): MIKE KING		SCALE:	HORIZONTAL: NTS VERTICAL: NTS	JOB NO: FSC38010	DWG NO: 1 OF 9

VICINITY MAP




DATE: 10/12/18	PROJECT PHASE: DESIGN	DESCRIPTION: CONSTRUCTION	CONSTRUCTION NOTE: FOLLOW DETAIL SHEETS FOR PLACEMENT OPERATIONS CONFORMING TO FEDERAL, STATE, & LOCAL CODES.	LOCATION: NA MTSO COLUMBIA	MCI METRO ACCESS TRANSMISSION SERVICES CORP. OUTSIDE PLANT CONSTRUCTION	PROJECT CODE: 1710AIEE.39	TITLE: VES2K 720 GRACER RD. COLUMBIA
	AS-BUILT			SCALE: HORIZONTAL: NTS		JOB NO: FSC38010	DWG NO: 9 OF 9
	REVISED			VERTICAL: NTS			
	REVISED(2)						
DRAFTED BY: C. EDWARDS	ENGINEER(S): MIKE KING						

MATCH TO SHEET 1

10+34	10+34	10+34	10+34
1	2	3	4
630	410	240	710
1656'	1856'	2.5'x5'x2.5'	1
4C	5C	4C	4C
D. BORE (1)2" HDPE	PULL (1) 432 FOC	PLACE HH	MKR POST

DETAIL 1

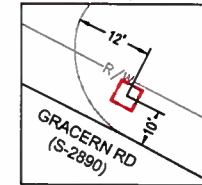

FIB:BUR::87000497
OSP:GSPAN::87018917

2/1/19

2/1/19
500' 1-2" Pipe

9' Run Line

34.017320°
-81.088424°

I-126 ENTRANCE RAMP

GRACERN RD (S-2890)

I-126

I-126



PROJECT: # 1710AIEE.39

SPAN: TBD

COLUMBIA, SC

RICHLAND COUNTY

MAP FOOTAGE:

SURVEY:

RAILROAD:

MATERIAL LIST	QUANTITY
ESTIMATED	ACTUAL
(1) 2" HDPE	1856'
(1) 432 FOC	1856'
2.5' X 5' X 2.5'	1
MARKER POST	1

McImetro

PROJECT NUMBER
1710AIEE.39
PROJECT TITLE
NA MTSO COLUMBIA
ROUTE 17: VES2K
720 GRACERN RD, COLUMBIA

TITLE: FIBER OPTIC CABLE ROUTE
FROM
GRACERN RD
TO
STONERIDGE DR

REVISIONS

DATE	DESCRIPTION	INITIAL

EXCEPT AS MAY BE OTHERWISE PROVIDED BY CONTRACT, THESE DRAWINGS AND SPECIFICATIONS SHALL REMAIN THE PROPERTY OF MCI METRO, INC. BEING ISSUED IN STRICT CONFIDENCE AND SHALL NOT BE REPRODUCED, COPIED, OR USED FOR ANY PURPOSE WITHOUT SPECIFIC WRITTEN PERMISSION.


SCALE

1:50

MP TBD TO MP TBD
SHEET 02 OF 05

DWG. NAME



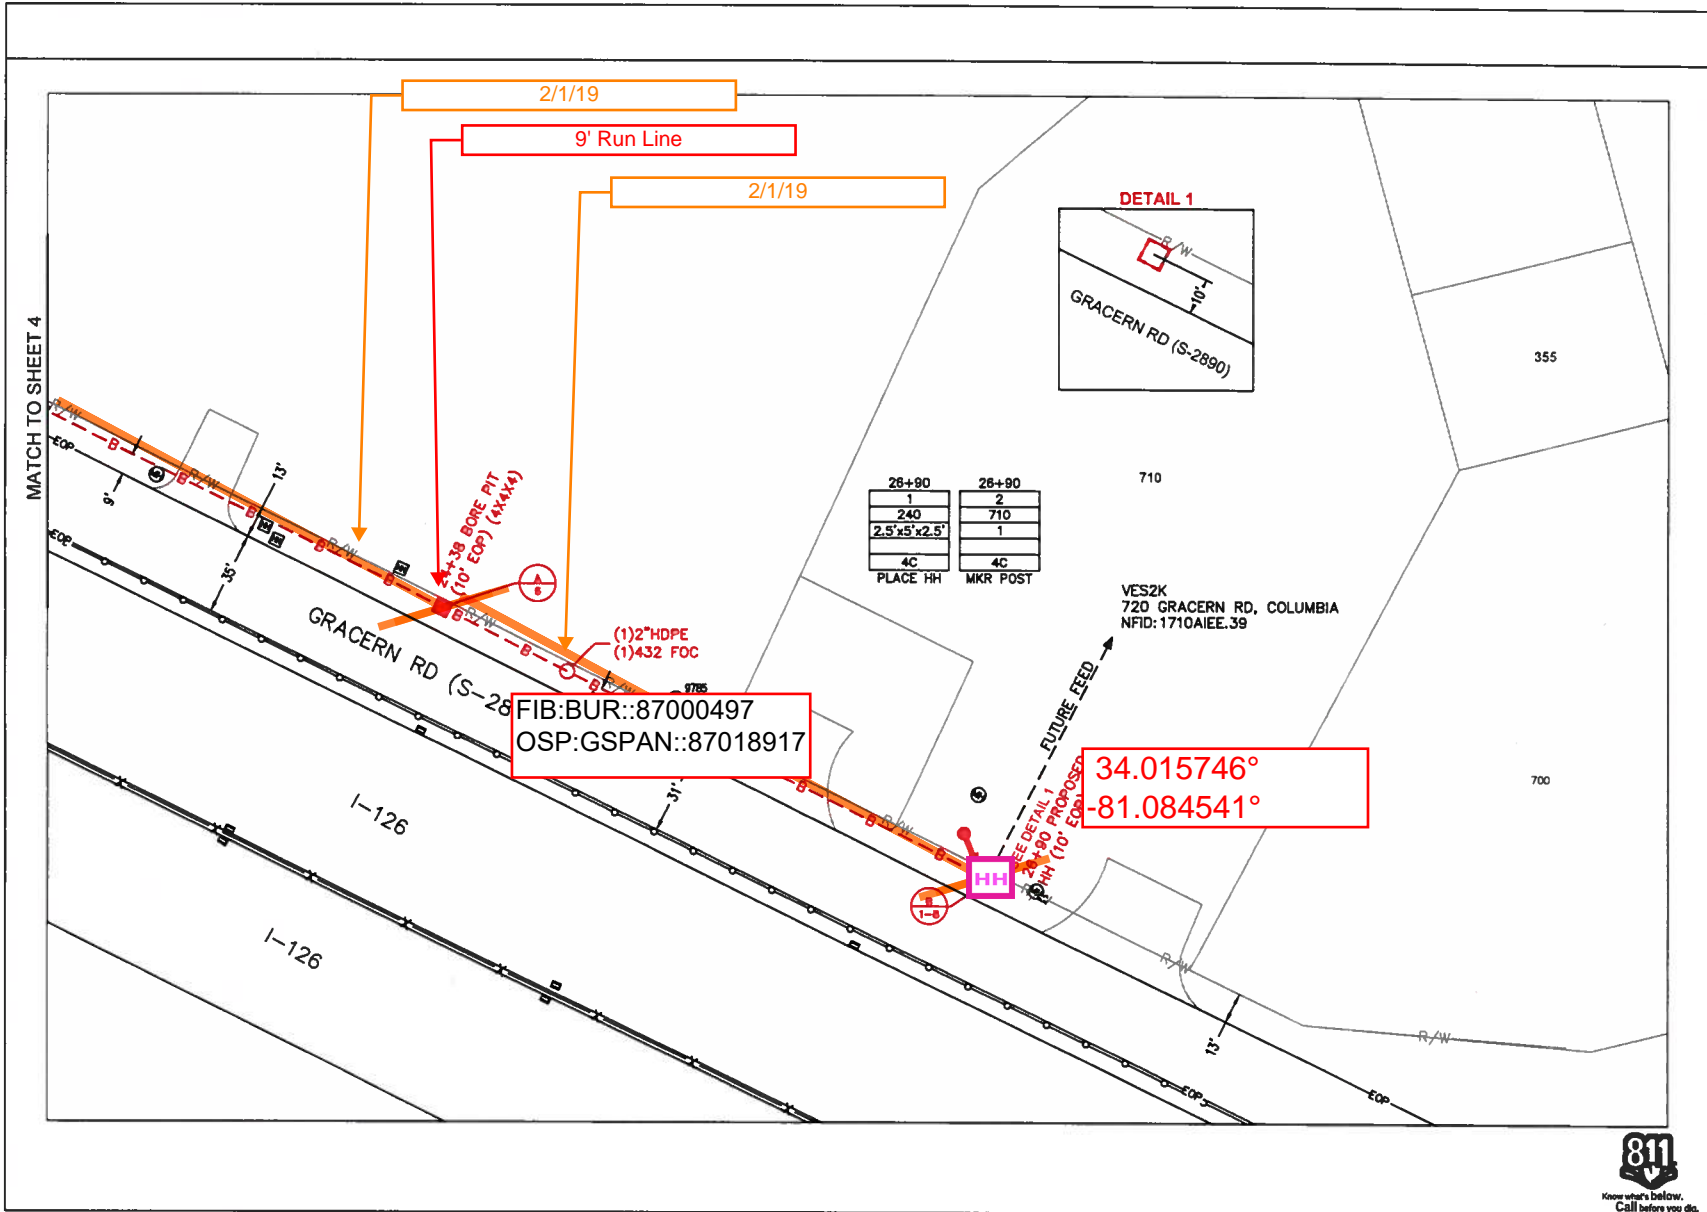

PROJECT: # 1710AIEE.39

SPAN: TBD

COLUMBIA, SC

RICHLAND COUNTY

MAP FOOTAGE:

SURVEY:

RAILROAD:

MATERIAL LIST	QUANTITY	
	ESTIMATED	ACTUAL
2.5' X 5' X 2.5'	1	
MARKER POST	1	

McMetro

PROJECT NUMBER

1710AIEE.39

PROJECT TITLE

NA MTSO COLUMBIA

ROUTE 17: VES2K

720 GRACERN RD, COLUMBIA

TITLE: FIBER OPTIC CABLE ROUTE

FROM

GRACERN RD

TO

STONERIDGE DR

REVISIONS

DATE	DESCRIPTION	INITIAL

EXCEPT AS MAY BE OTHERWISE PROVIDED BY CONTRACT, THESE DRAWINGS AND SPECIFICATIONS SHALL REMAIN THE PROPERTY OF MCMETRO, INC. NO PART OF THESE DRAWINGS OR SPECIFICATIONS SHALL BE REPRODUCED, COPIED, OR USED FOR ANY PURPOSE WITHOUT SPECIFIC WRITTEN PERMISSION.

SCALE

1:50

MP TBD TO MP TBD

SHEET 05 OF 05

DWG. NAME