


PROFILE	SURVIVED	BY	DATE
NOTE BOOK	PLOTTER	R. SLICE	10-81
	GRADES CHECKED	JONES	12-81
	ILL. M.4. NOTED		
No. 368	STRUCTURE NOTATIONS CHECKED		



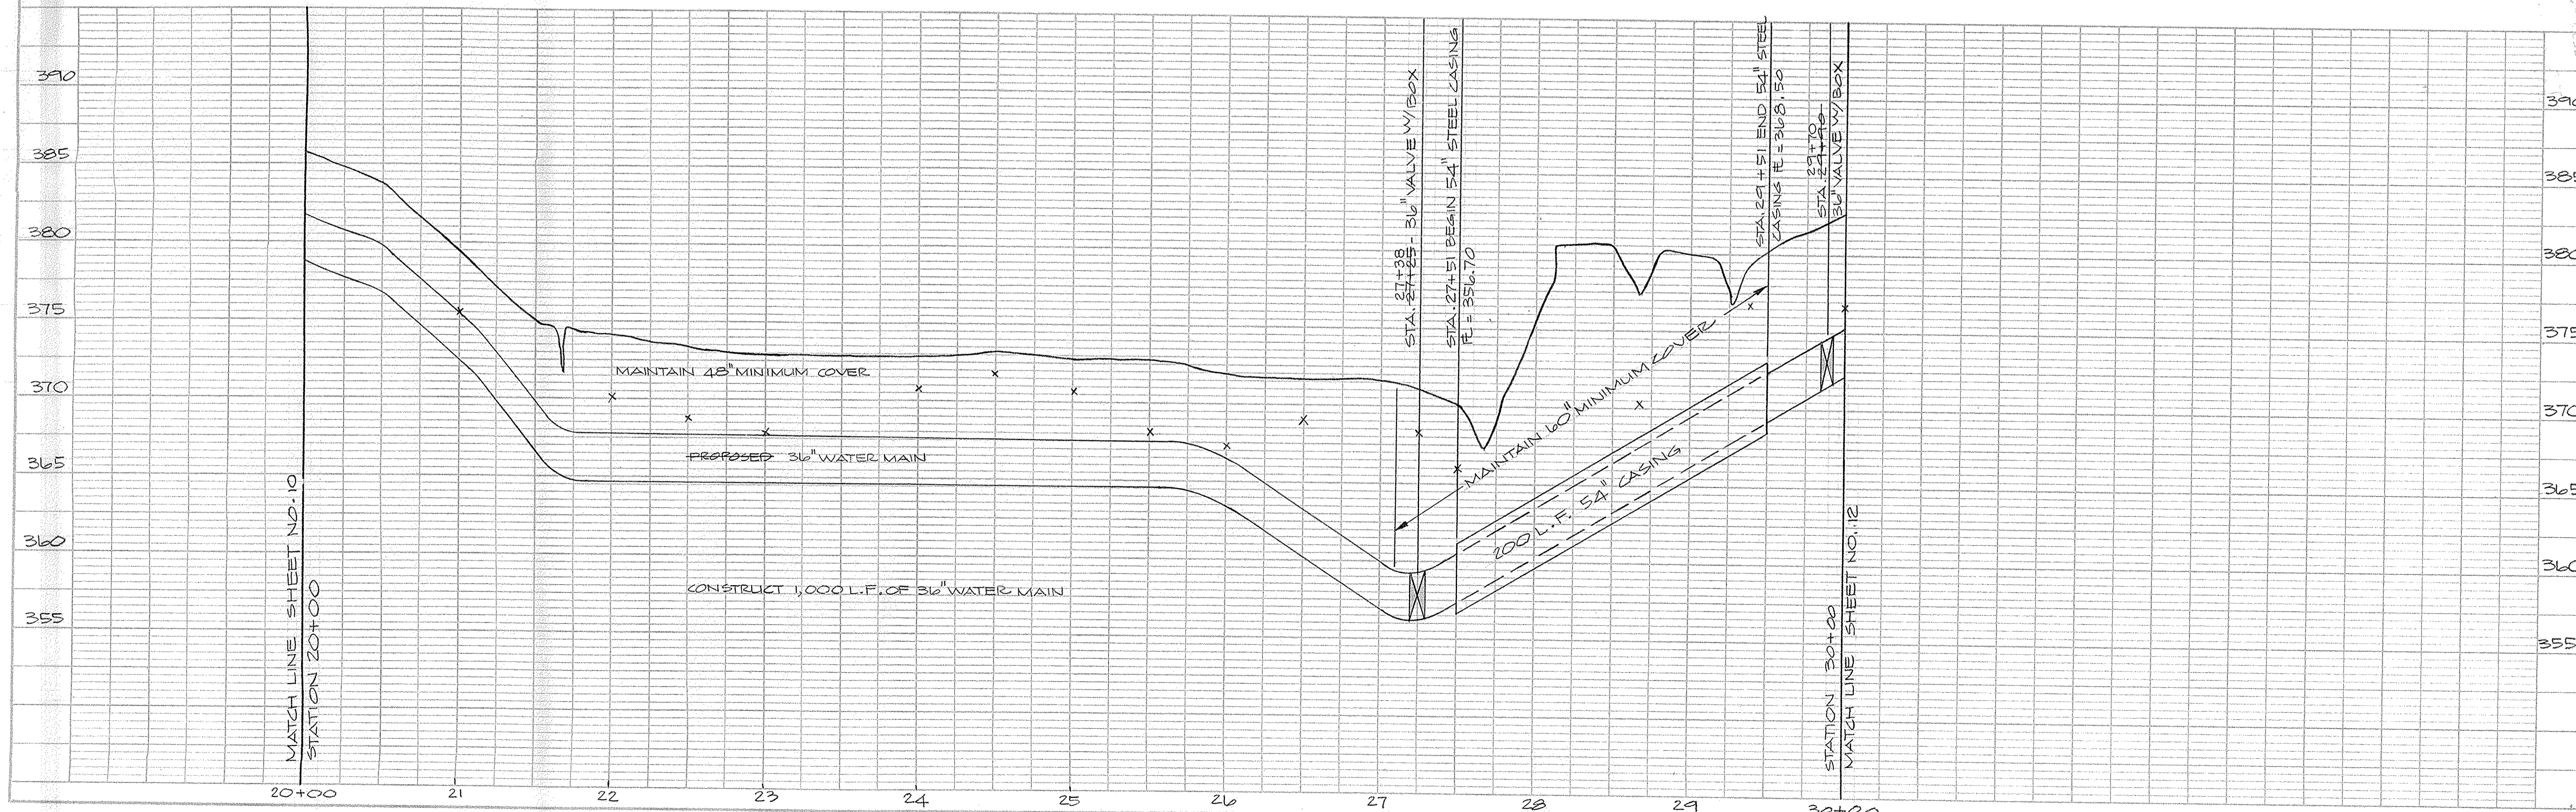


SPECIAL ITEMS THIS SHEET  
R & R FENCE NEAR STA. 27+12

CONSTRUCTION NOTES & TO FOLLOW \$

SCALE :      HORIZ.      1" = 50  
                     VERT.        1" = 5

BENCHMARK : CHISHOLD SQ. ON SW  
CORNER WING WALL @ I-26 OVERPASS  
ON HWY. S-40-58  
ELEV. = 424.97 MSL

		CITY OF COLUMBIA DEPARTMENT OF ENGINEERING COLUMBIA, SOUTH CAROLINA	
		SCALE: AS SHOWN DATE: JUNE 10-1982	APPROVED BY:  RESIDENT ENGINEER
W/05-1/2-E3, 4, F1 WATER MAIN CONSTRUCTION FROM BALLANTINE TANK TO ST. JAMES TANK ALONG EASTERN SIDE OF I-26 & US HWY 170 - PART I			
FIELD BOOK NO.: 367 & 368		DATE SENT TO PUBLIC WORKS	DATE AS-BUILT RETURNED
DRAWING NUMBER 11 OF 35			
APPROVED BY: 	DATE 2-19-89	REVISION NUMBER AND DESCRIPTION REVISED TO SHOW AS-BUILT SURVEY FIELD BOOK NO. 431	
		DRAWN BY PTH	DATE 12-8-86

160-12

W105-1/2-E3,4;F4  
SHEET 11 OF 35