



NOTES:

1. THE CONTRACTOR SHALL LOCATE THE 15" DIA. 18" DI. WATER LINE PRIOR TO LAYING THE 15" DI. SEWER. BETWEEN WWS 85 AND 88 THE 15" DI. SEWER PIPE SHALL BE LAYED SO THAT THE WATER LINE SHALL BE AS FAR AS POSSIBLE FROM THE SEWER LINE (P.S.). THE DIPS AND TYPINGS SHALL BE SHOWN AS LOCATED.
2. THE CONTRACTOR SHALL NOTIFY THE CITY OF RICHLAND COUNTY, RICHLAND COUNTY, S.C. 29101, BEFORE LAYING THE SEWER FROM WWS 85 TO 88. THIS CONCERN REPRESENTATION PRESENTLY WHILE THE SEWER LINE IS BEING LAYED ACROSS THESE WATER LINES.

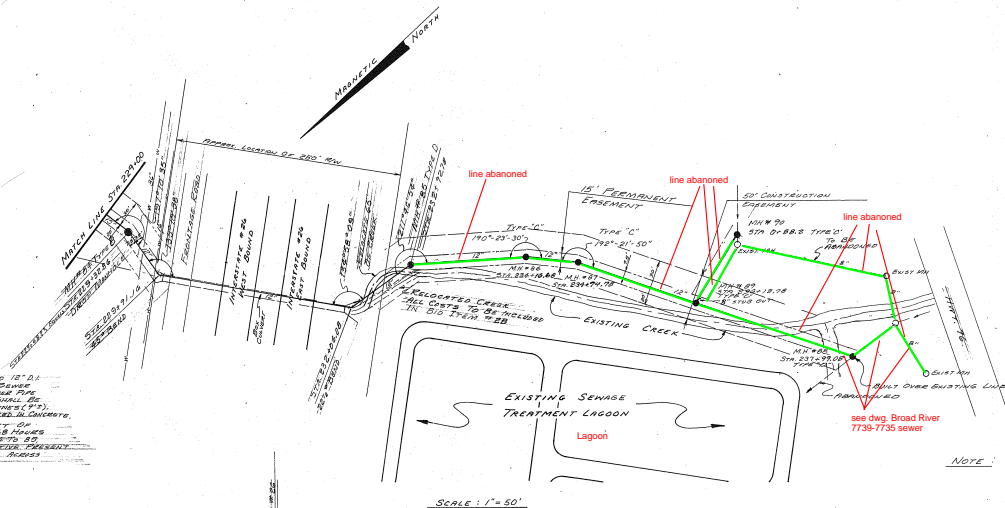

NOTE: THE CONTRACTOR SHALL PLUG EXISTING INVERT OUT ON MANHOLE AND SENDER M.H. IS REQUIRED.

SCALE: 1" = 50'

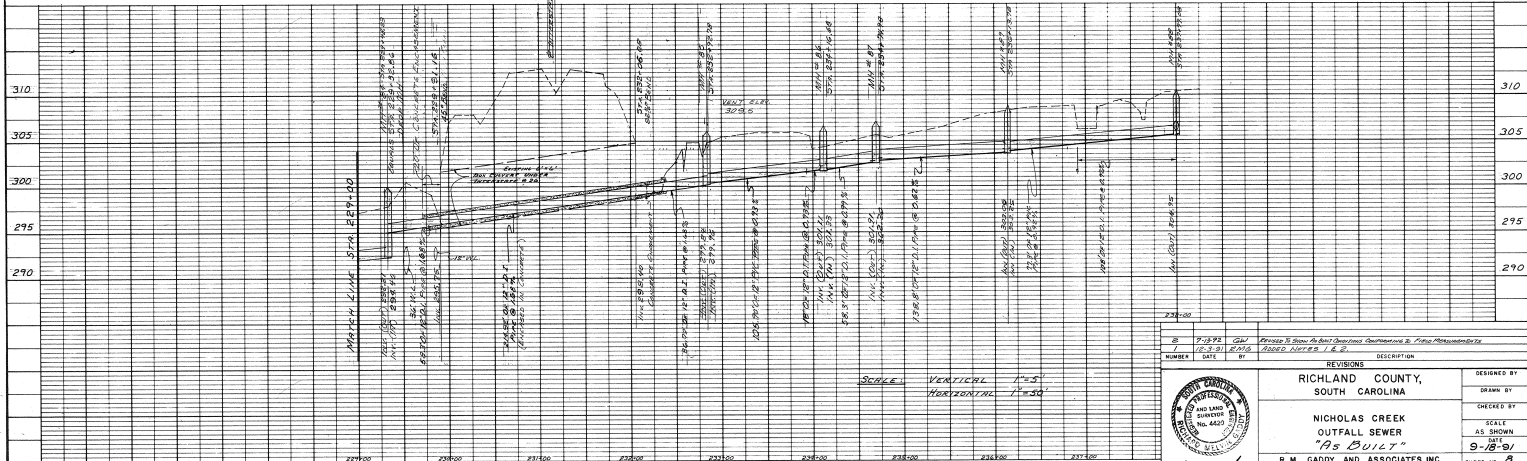

SCALE: VERTICAL 1" = 5' HORIZONTAL 1" = 30'

8 7-12-92 G.M. 1 10-1-92 R.M. NUMBER DATE BY		Revision 11 Show As Built Drawings, Outfalls and 15" Water Main Installation REVISIONS DESCRIPTION	
DESIGNED BY GRAB BY CHECKED BY SCALE AS SHOWN 9-18-97		RICHLAND COUNTY, SOUTH CAROLINA NICHOLAS CREEK OUTFALL SEWER "95" BUILT R. M. GADY, AND ASSOCIATES INC.	