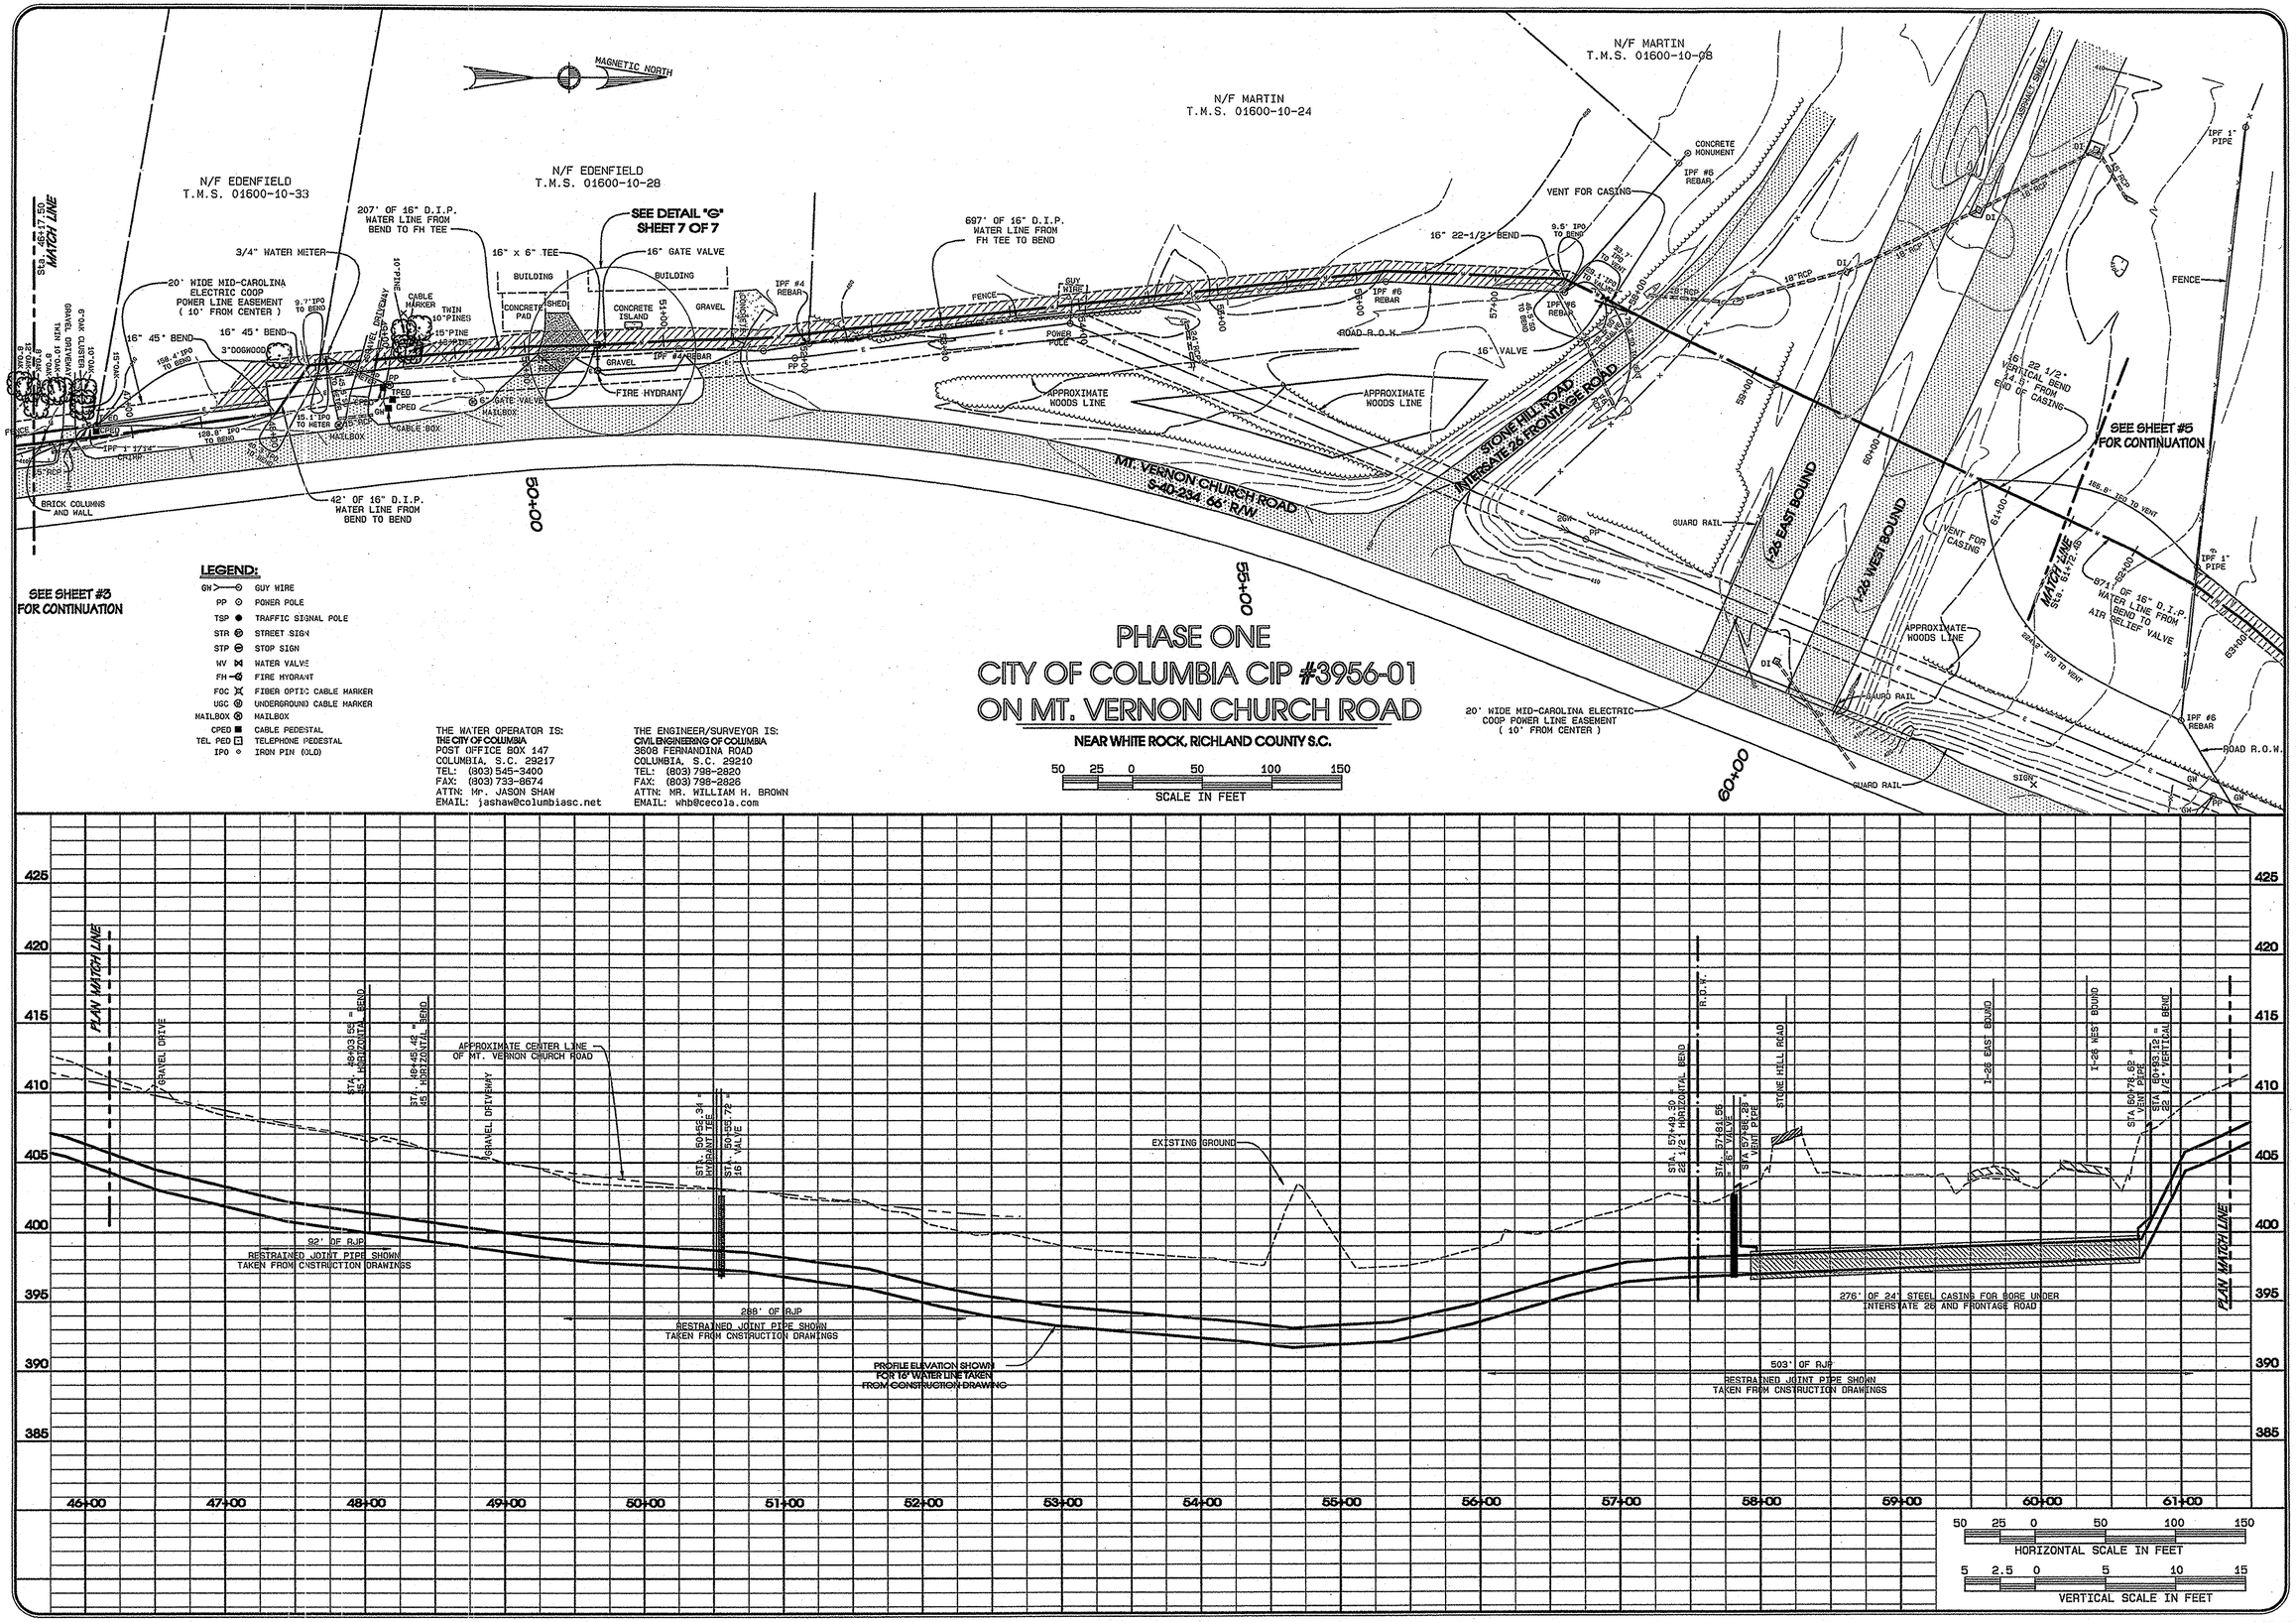

LEGEND:

GW	GUY WIRE
PP	POWER POLE
TSP	TRAFFIC SIGNAL POLE
STR	STREET SIGN
STP	STOP SIGN
WV	WATER VALVE
FH	FIRE HYDRANT
FOC	FIBER OPTIC CABLE MARKER
UGC	UNDERGROUND CABLE MARKER
MAILBOX	MAILBOX
CPED	CABLE PEDESTAL
TEL PED	TELEPHONE PEDESTAL
IPO	IRON PIN (OLD)

PHASE ONE
CITY OF COLUMBIA CIP #3956-01
ON MT. VERNON CHURCH ROAD

NEAR WHITE ROCK, RICHLAND COUNTY S.C.

50 25 0 50 100 150
SCALE IN FEET

THE WATER OPERATOR IS:
THE CITY OF COLUMBIA
POST OFFICE BOX 147
COLUMBIA, S.C. 29217
TEL: (803) 545-3400
FAX: (803) 733-8674
ATTN: Mr. JASON SHAW
EMAIL: jashaw@columbiasc.net

THE ENGINEER/SURVEYOR IS:
CIVIL ENGINEERING OF COLUMBIA
3608 FERNANDINA ROAD
COLUMBIA, S.C. 29210
TEL: (803) 798-2820
FAX: (803) 798-2826
ATTN: MR. WILLIAM H. BROWN
EMAIL: whb@cecola.com

50 25 0 50 100 150
HORIZONTAL SCALE IN FEET

5 2.5 0 5 10 15
VERTICAL SCALE IN FEET

REVISION			
NO.	DATE	DESCRIPTION	BY
1	10-19-13	REV. DOES NOT APPLY THIS SHEET	HDE

SOUTH CAROLINA — CIVIL ENGINEERING OF COLUMBIA, INC. NO. 000295 — CERTIFICATE OF AUTHORIZATION

CIVIL ENGINEERING of COLUMBIA
CONSULTING ENGINEERING, SURVEYING AND PLANNING
3608 FERNANDINA ROAD, COLUMBIA, SOUTH CAROLINA 29210
TELEPHONE (803) 798-2820 FAX (803) 798-2826

ANY CERTIFICATIONS, WARRANTIES, OR GUARANTEES SIGNED BY THE ENGINEER OR SURVEYOR OF RECORD PERTAIN TO FACTS AND REPORTS IN THE DRAWINGS AS THEY EXISTED AT THE TIME OF THE PREPARATION OF THESE DOCUMENTS.

SOUTH CAROLINA PROFESSIONAL ENGINEER — WILLIAM H. BROWN — NO. 4953 — REGISTERED LAND SURVEYOR

WATER RECORD DRAWING

PREPARED FOR
THE CITY OF COLUMBIA
COLUMBIA, SOUTH CAROLINA

JOB NUMBER 10042

CHECKED BY: WHB

SCALE	AS SHOWN
DATE	FEB. 11, 2013
DRAWN	HDE
DESIGNED	DINKINS
DRAWING NUMBER	5 OF 7

CIP #WM3956-01